

LABOR AND MATERIALS

1	Copper Lead	Connection	3/4"	\$	2.71
1	Curb	Cock Valve T.S. & V.	3/4 in.	\$	3.83
1	Service box	Short 3 1/2 x 4 1/2		\$	4.69
	Old returned	Long 4 1/2 x 5 1/2		\$	
		Buff or Rdway		\$	
25	Ft.	Copper G.I. C.I.	3/4 in. Pipe at 45	\$	11.25
	Nipples	in. at		\$	
	Bushings	to in. at		\$	
	Red'g Inc'g	Coupl'gs. to in. at		\$	
	Union	in. at		\$	
	Meter	in. at		\$	
	Lead Joints	at		\$	
	Compound Joints	at		\$	
	Maintenance Foreman			\$	27.89
	Hrs. Water Maint. Man-1	at		\$	
7	Hrs. Water Maint. Man-2	at 1.24		\$	8.68
	Hrs. Garage Foreman	at		\$	
17	Hrs. Labor	at 1.13		\$	19.21
	Hrs. Compressor	at		\$	
	Compensation Ins.	at \$4.29 per C		\$	1.19
	Trucking			\$	1.50
	Pav't Patch			\$	12.15
	Tap by Gissard	10-19-55		\$	
	O'head			\$	
				\$	65.21

5306


McArthur Dr. Ave. No. 35

Name of Owner

Shanes

Labor and Mat'l. Report

Oct. 19 1955

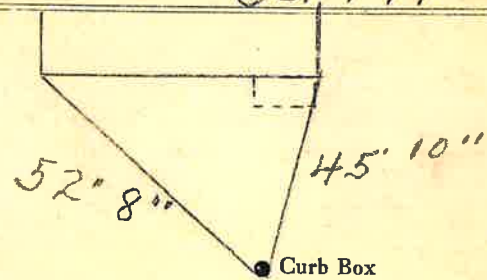

12" Main

Elev. of Main at tap 5 1/2'

Gate at •

• Gate at

24' to main

• Curb Box

129