

### LABOR AND MATERIALS

1	Copper	Connection	3/4		\$ 2.94
	Lead				
1	Curb	Cock Valve	3/4 in.		\$ 3.71
		T. S. & V.			
1	Service box	Short 3 1/2 X 4 1/2			
	Old returned	Long 4 1/2 X 5 1/2			\$ 5.90
		Buff or Rdway			
11	Ft.	Copper	3/4 in.	Pipe at 30	\$ 3.30
		G. I.			
		G. I.			
	Nipples			in. at	\$
	Bushings			to in. at	\$
	Red'g				\$
	Inc'g	Coupl'gs		to in. at	\$
	Union			in. at	\$
	Meter			in. at	\$
	Lead Joints			at	\$
	Compound Joints			at	\$
	Hrs. Water Maint. Man-1			at	\$
4	Hrs. Water Maint. Man-2		91		\$ 3.64
13	Hrs. Labor-		80		\$ 10.40
	Hrs. Labor-			at	\$
	Hrs. Compressor			at	\$
	Compensation Ins.		\$ 220.7	per C	\$ 21
	Trucking				\$ 1.00
	Pav't Patch				\$
	Tap				\$
	O'head				\$
					\$

49

# 36

St. *Lot*  
Pl. *40*  
Ave. No. *40*


*McArthur Drive*

Name of Owner

*C. Hyman*

Labor and Mat'l. Report

*July 28 1948*

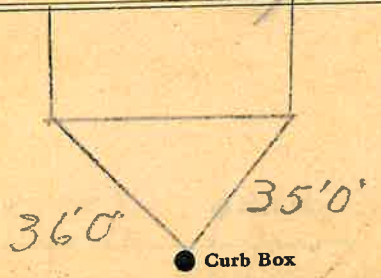

*12* Main

Elev. of Main at tap *5*

Gate at ●

● Gate at

● Curb Box