

LABOR AND MATERIALS


|    |                         |                      |         |    |       |
|----|-------------------------|----------------------|---------|----|-------|
| 1  | Copper Lead             | Connection           | 3/4"    | \$ | 2.71  |
| 1  | Curb                    | Cock Valve T.S. & V. | 3/4 in. | \$ | 3.83  |
| 1  | Service box             | Short 3 1/2 x 4 1/2  |         | \$ |       |
|    | Old returned            | Long 4 1/2 x 5 1/2   |         | \$ | 4.69  |
|    |                         | Buff or Rdway        |         | \$ |       |
| 24 | Ft. 3/4 in.             | Copper G.I. Pipe at  | 45      | \$ | 10.80 |
|    | Nipples                 | in. at               |         | \$ |       |
|    | Bushings                | to in. at            |         | \$ |       |
|    | Red'g Inc'g             | Coupl'gs to in. at   |         | \$ |       |
|    | Union                   | in. at               |         | \$ |       |
|    | Meter                   | in. at               |         | \$ |       |
|    | Lead Joints             | at                   |         | \$ |       |
|    | Compound Joints         | at                   |         | \$ |       |
|    | Maintenance Foreman     |                      |         | \$ |       |
|    | Hrs. Water Maint. Man-1 | at                   |         | \$ |       |
| 6  | Hrs. Water Maint. Man-2 | at                   | 1.24    | \$ | 7.44  |
|    | Hrs. Garage Foreman     | at                   |         | \$ |       |
| 18 | Hrs. Labor              | at                   | 1.13    | \$ | 20.34 |
|    | Hrs. Compressor         | at                   |         | \$ |       |
|    | Compensation Ins.       | at \$ 4.29 per C     |         | \$ | 1.19  |
|    | Trucking                |                      |         | \$ | 1.50  |
|    | Pav't Patch             |                      |         | \$ | 12.15 |
|    | Tap by Giffard          | 10-20-55             |         | \$ |       |
|    | O'head                  |                      |         | \$ |       |
|    |                         |                      |         | \$ | 64.65 |

52.50

St. McArthur Dr.  
Pl. 37  
Ave. No. 37

Name of Owner Forrest

Labor and Mat'l. Report Oct 20 1955

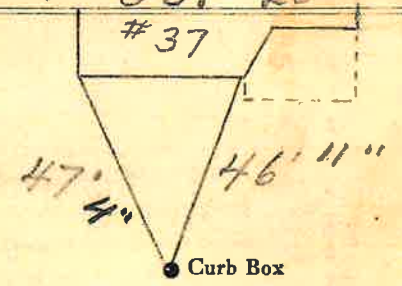

12\"/>

Gate at ● ● Gate at

● Curb Box

# 130