

LABOR AND MATERIALS

1	Copper	Connection	3/4		\$ 2.94
	Lead				
1	Curb	Cock Valve	3/4	in.	\$ 3.71
		T. S. & V.			
1	Service box	Short 3/2 X 4 1/2			\$ 5.90
	Old returned	Long 4 1/2 X 5 1/2			
		Buff or Rdway			
8	Ft.	Copper G. I. C. I.	3/4	Pipe at	30 \$ 2.40
	Nipples	in. at			\$
	Bushings	to in. at			\$
	Red'g				
	Inc'g	Coupl'gs. to in. at			\$
	Union	in. at			\$
	Meter	in. at			\$
	Lead Joints at				\$
	Compound Joints at				\$
4	Hrs.	Water Maint. Man-1 at	1.01		\$ 4.04
10	Hrs.	Water Maint. Man-2 at	91		\$ 9.10
11	Hrs.	Labor- at	80		\$ 8.00
	Hrs.	Labor- at			\$
	Hrs.	Compressor at			\$
	Compensation Ins. at \$		per C		\$ 48
	Trucking				\$ 1.02
	Pav't Patch				\$
	Tapped by Miller				\$
	O'head				\$
					\$ 38.39

50


38

St. Hot
Pl. 41
Ave. No.

Name of Owner

C. Lyman

Labor and Mat'l. Report June 18 1948

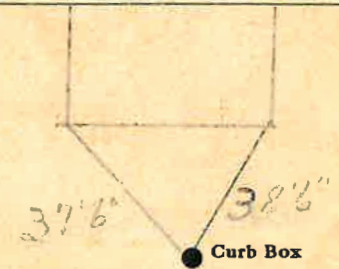

12 Main

Elev. of
Main at tap

Gate at ●

● Gate at

TAX ID # 302.12-8-5

● Curb Box