

LABOR AND MATERIALS

1 Copper Connection $\frac{3}{4}$	\$ 2.94
1 Lead.....	
1 Curb { Cock Valve } $\frac{3}{4}$ in.....	\$ 3.71
1 T. S. & V. { }.....	
1 Service box { Short $3\frac{1}{2}$ X $4\frac{1}{2}$ }.....	\$ 5.90
Old returned { Long $4\frac{1}{2}$ X $5\frac{1}{2}$ }.....	
10 Ft. $\frac{3}{4}$ in. { Buff or Rdway }.....	\$ 3.00
10 Ft. $\frac{3}{4}$ in. { Copper }.....	
10 Ft. $\frac{3}{4}$ in. { G. I. } Pipe at 30.....	\$ 3.00
10 Ft. $\frac{3}{4}$ in. { C. I. }.....	
Nipples..... in. at.....	\$
Bushings..... to..... in. at.....	\$
Red'g { Inc'g } Coupl'gs..... to..... in. at.....	\$
Union..... in. at.....	\$
Meter..... in. at.....	\$
Lead Joints at.....	\$
Compound Joints at.....	\$
Hrs. Water Maint. Man—1 at.....	\$
6 Hrs. Water Maint. Man—2 at 91.....	\$ 5.46
16 Hrs. Labor— at 80.....	\$ 12.80
Hrs. Labor— at.....	\$
Hrs. Compressor at.....	\$
Compensation Ins. at \$..... per C.....	\$ 40
1 Trucking.....	\$ 1.00
Pav't Patch.....	\$
Tally McGuinn.....	\$
O'head.....	\$
	\$ 35.31


51

40

St. loc
Pl. # 42
Ave. No.

McArthur Ave.
Name of Owner Geo. I. Moore
E. Legman

Labor and Mat'l. Report July 29 1948

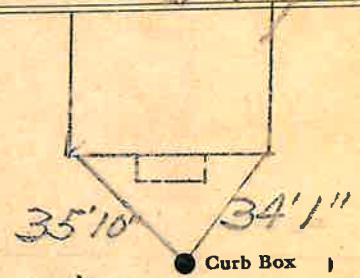

12 Main Elev. of Main at tap 5

Gate at ● Gate at ●
Curb Box ●