

LABOR AND MATERIALS

1 Copper / Lead Connection $\frac{3}{4}$ in.	\$ 2.94
1 Curb { Cock Valve T. S. & V. } $\frac{3}{4}$ in.	\$ 3.71
Service box { Short $3\frac{1}{2} \times 4\frac{1}{2}$ Long $4\frac{1}{2} \times 5\frac{1}{2}$ Buff or Rdway }	\$ 5.90
9 Ft. $\frac{3}{4}$ in. { Copper G. I. C. I. } Pipe at 30	\$ 2.70
Nipples in. at	\$
Bushings to in. at	\$
Red'g / Inc'g / Coupl'gs to in. at	\$
Union in. at	\$
Meter in. at	\$
Lead Joints at	\$
Compound Joints at	\$
Hrs. Water Maint. Man—1 at	\$
4 Hrs. Water Maint. Man—2 at 1.02	\$ 4.08
8 Hrs. Labor— at 91	\$ 728.11
Hrs. Labor— at	\$
Hrs. Compressor at	\$
Compensation Ins. at \$ per C	\$ 25
Trucking	\$ 1.00
Pav't Patch	\$
Tap by <i>M. J. [unclear]</i>	\$
O'head	\$
	\$ 27.86

143


McArthur Dr St. 48
~~St.~~ ~~48~~
~~Pl.~~ ~~49~~
~~Ave. No.~~ 49

Name of Owner

Hart

Labor and Mat'l. Report

Oct 11 19 *45*

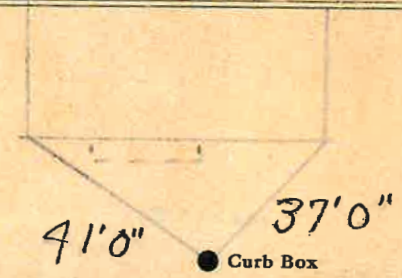

12 Main

Elev. of Main at top *5*

Gate at ●

● Gate at

TAX ID # 302.12-3-6

● Curb Box

Curb Box to be shut off