


LABOR AND MATERIALS

1	Copper	Connection	<u>3/4"</u>		\$	
	Lead	Cock	<u>Orisco</u>		\$	
1	Curb	Valve	<u>3/4"</u>	in.	\$	
		T.S. & V.				
1	Service box	Short	<u>3 1/2</u>	x	<u>4 1/2</u>	
	Old returned	Long	<u>4 1/2</u>	x	<u>5 1/2</u>	
		Buff or Rdway				\$
12	Pt.	Copper		in.	at	\$
		G.I.				
		G.I.				
	Nipples	in.		at	\$	
	Bushings	to		in.	at	\$
	Red'g	Coupl'gs				
	Inc'g		to		in.	at
	Union	in.		at	\$	
	Meter	in.		at	\$	
	Lead Joints	at			\$	
	Compound Joints	at			\$	
	Maintenance Foreman				\$	
	Hrs. Water Maint. Man	1		at	\$	
	Hrs. Water Maint. Man	2		at	\$	
	Hrs. Garage Foreman			at	\$	
	Hrs. Labor			at	\$	
	Hrs. Compressor	at			\$	
	Compensation Ins.	at \$		per C	\$	
	Trucking				\$	
	Pay't Patch				\$	
	<u>Top Bugis Ford & Co</u>					\$
	<u>April - 6 - 65</u>					\$
						\$
						\$
	O'head				\$	

M C
 Mac Arthur Dr St. Pl. Ave. No. 52

Name of Owner
R Champaign
 Labor and Mat'l. Report April 6 1965

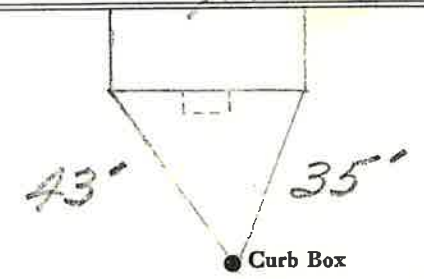

12" Main Elev. of Main at tap 5'
 Gate at • Gate at •

• Curb Box