

LABOR AND MATERIALS


1 Copper } Connection $\frac{3}{4}$ " \$
 Lead }
 1 Curb } Cock } $\frac{3}{4}$ in. 0-15 seal \$
 Valve }
 T.S. & V. }
 1 Service box } Short $3\frac{1}{2} \times 4\frac{1}{2}$ }
 Old returned } Long $4\frac{1}{2} \times 5\frac{1}{2}$ } \$
 Buff or Rdway }
 14 Ft. $\frac{3}{4}$ in. } Copper } Pipe at \$
 } G.I. }
 } C.I. }
 Nipples in. at \$
 Bushings to in. at \$
 Red'g }
 Inc'g } Coupl'gs to in. at \$
 Union in. at \$
 Meter in. at \$
 Lead Joints at \$
 Compound Joints at \$
 Maintenance Foreman \$
 Hrs. Water Maint. Man-1 at \$
 Hrs. Water Maint. Man-2 at \$
 Hrs. Garage Foreman at \$
 Hrs. Labor at \$
 Hrs. Compressor at \$
 Compensation Ins. at \$ per C \$
 Trucking \$
 Pav't Patch \$
 Tap by Larea V & Co. \$
 12-8-65. \$
 \$
 \$
 O'head \$
 \$

Dr.
 St.
 Pl.
 Ave. No. 56

McArthur

Name of Owner
 Sol DeGennaro

Labor and Mat'l. Report Dec. 8 1965

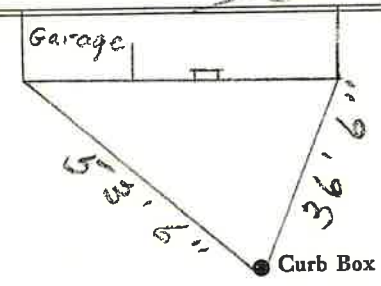

12" Main Elev. of Main at tap 4 1/4
 Gate at • Gate at •

• Curb Box