


LABOR AND MATERIALS

$\frac{3}{4}$ Copper } Connection _____ \$ _____
 Lead }
 $\frac{3}{4}$ Curb } Cock } _____ in. \$ _____
 Valve }
 T-S. & V. }
 $\frac{3}{4}$ Service box } Short $3\frac{1}{2}$ x $4\frac{1}{2}$ }
 Old returned } Long $4\frac{1}{2}$ x $5\frac{1}{2}$ }
 } Buff or Ridway } _____ \$ _____
 25 Ft. $\frac{3}{4}$ in. } Copper } Pipe at _____ \$ _____
 } G.I. }
 } G.I. }
 Nipples in. at _____ \$ _____
 Bushings to in. at _____ \$ _____
 Red'g }
 Inc'g } Coupl'gs to in. at _____ \$ _____
 Union in. at _____ \$ _____
 Meter in. at _____ \$ _____
 Lead Joints at _____ \$ _____
 Compound Joints at _____ \$ _____
 Maintenance Foreman _____ \$ _____
 Hrs. Water Maint. Man-1 at _____ \$ _____
 Hrs. Water Maint. Man-2 at _____ \$ _____
 Hrs. Garage Foreman at _____ \$ _____
 Hrs. Labor— at _____ \$ _____
 Hrs. Compressor at _____ \$ _____
 Compensation Ins. at \$ _____ per C _____ \$ _____
 Trucking _____ \$ _____
 Pav't Patch _____ \$ _____
 _____ \$ _____
 _____ \$ _____
 June 27, 1977 _____ \$ _____
 Beecher & Co. _____ \$ _____
 O'head _____ \$ _____
 _____ \$ _____

✓
 St. _____
 Pl. _____
 Ave. No. 57

Name of Owner
Fredrick Hart

Labor and Mat'l. Report June 27 1977

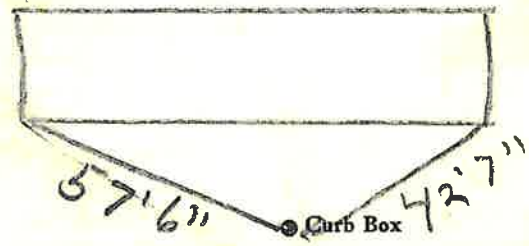

12" Main _____ Elev. of Main at tap 5'

Gate at • _____ • Gate at _____

• Curb Box