


LABOR AND MATERIALS

1	Copper Lead	Connection	$\frac{3}{4}$	\$	
1	Curb	Cock Valve T.S. & V.	$\frac{3}{4}$ in.	\$	
1	Service box	} Short $2\frac{1}{2} \times 4\frac{1}{2}$ Long $4\frac{1}{2} \times 5\frac{1}{2}$ Buff or Rdway		\$	
	Old returned				
21	Ft.	Copper G.I. C.I.	$\frac{3}{4}$ in. Pipe at	\$	
	Nipples	in. at		\$	
	Bushings	to in. at		\$	
	Red'g Inc'g	Coupl'gs to in. at		\$	
	Union	in. at		\$	
	Meter	in. at		\$	
	Lead Joints	at		\$	
	Compound Joints	at		\$	
	Maintenance Foreman			\$	
	Hrs. Water Maint. Man	1 at		\$	
	Hrs. Water Maint. Man	2 at		\$	
	Hrs. Garage Foreman	at		\$	
	Hrs. Labor	at		\$	
	Hrs. Compressor	at		\$	
	Compensation Ins.	at \$ per C		\$	
	Trucking			\$	
	Pav't Patch			\$	
	Tap	Sept 29, 1977		\$	
	O'head			\$	

~~St~~
~~Pl~~
McArthur Dr. Ave. No. 61

Name of Owner
Wesley C. Veysey

Labor and Mat'l. Report Sept 29, 1977

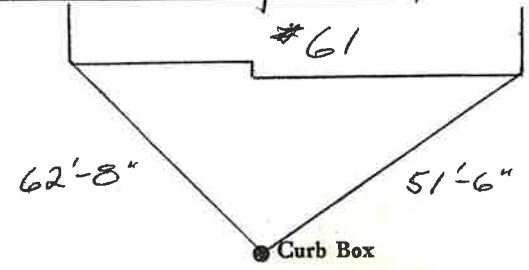

12" Main Elev. of Main at tap 5'
Gate at • Gate at •

• Curb Box