

LABOR AND MATERIALS


1	Copper Lead	{ Connection	3/4"	\$	3.04
1	Curb	{ Cock Valve T.S. & V.	3/4 in.	\$	3.54
1	Service box	{ Short 3 1/2 x 4 1/2		\$	4.70
	Old returned	{ Long 4 1/2 x 5 1/2		\$	
		{ Buff. or Rdway		\$	
10	Ft. 3/4 in.	{ Copper	Pipe at 35	\$	3.50
		{ G.I.		\$	
		{ C.I.		\$	
	Nipples	in. at		\$	
	Bushings	to in. at		\$	
	Red'g Inc'g	{ Coupl'gs to in. at		\$	
	Union	in. at		\$	
	Meter	in. at		\$	
	Lead Joints at			\$	
	Compound Joints at			\$	
1	Hrs. Water Maint. Man-1	at		\$	1.23 m
6	Hrs. Water Maint. Man-2	at 113		\$	6.78
6	Hrs. Labor	at 1.02		\$	6.12
	Hrs. Labor	at		\$	
1	Hrs. Compressor at			\$	1.50
	Compensation Ins. at \$	per C.		\$	38
	Trucking			\$	1.00
	Pav't Patch			\$	6.75
				\$	
				\$	
	O'head			\$	
	Tap by Gifford			\$	38.54
	9-17-51				

149-1951

MacArthur Dr. St. Pl. Ave. No. 20

Name of Owner Daniel Huff

Labor and Mat'l. Report Sept. 17 1951

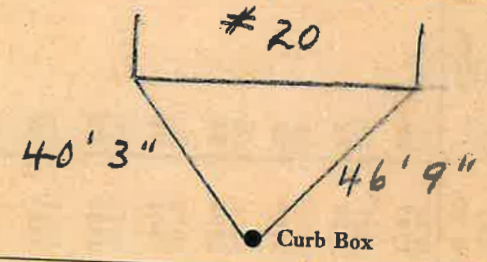

12" Main Elev. of Main at tap 4'

Gate at • Gate at

TAX ID # 302.12-9-1

• Curb Box