

LABOR AND MATERIALS


1	Copper	{ Connection	3/4"		\$ 2.29
	Lead				
1	Curb	{ Cock Valve T.S. & V.	3/4 in.		\$ 2.70
1	Service box	{ Short 3 1/2 x 4 1/2			
	Old returned	{ Long 4 1/2 x 5 1/2			
		{ Buff or Rdway			\$ 4.25
10	Ft. 3/4 in.	{ Copper			
		{ G.I.			
		{ G.I.			
		Pipe at	35		\$ 3.50
	Nipples	in. at			\$
	Bushings	to in. at			\$
	Red'g	{ Coupl'gs to in. at			\$
	Inc'g				\$
	Union	in. at			\$
	Meter	in. at			\$
	Lead Joints at				\$
	Compound Joints at				\$
	Hrs. Water Maint. Man-1 at				\$
5	Hrs. Water Maint. Man-2 at	1.07			\$ 5.10
8	Hrs. Labor at	91			\$ 728
	Hrs. Labor at				\$
1	Hrs. Compressor at				\$ 1.20
	Compensation Ins. at \$	per C.			\$ 28
	Trucking				\$
	Pav't Patch				\$ 8.10
	Tap by Moquin				\$
	O'head				\$
					\$ 35.70

174-1850

St.
Pl.
MacArthur Drive Ave. No. 22

Name of Owner
MacKenzie Lance

Labor and Mat'l. Report Sept. 18 1950

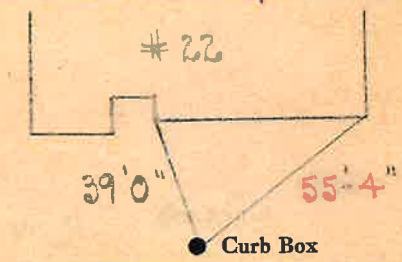

12" Main Elev. of Main at tap 5'

Gate at ● ● Gate at

● Curb Box