


Labor and Materials

Copper } Connection.....	3	\$.96
Lead }		
Curb { Cock }		\$ 1.33
{ Valve }		
{ g. S&V }		
Service Box { Short 2 1/2 x 4 1/2 }		\$ 1.35
Old returned { Long 4 1/2 x 5 1/2 }		
{ Buff or Rdwa. }		
21 Ft. in. { Copper } Pipe at 1.5		\$ 3.90
{ Galv. Iron }		
{ Cast Iron }		
Nipples	4	\$
Bushings		\$
Red'g } Couplings..... to		\$
Inc'g }		
Union..... in. at		\$
Meter..... in. at		\$
Lbs. Br. Stone at		\$
Lbs. Sand at		\$
Bags Cement at		\$
Paving Brick { Mack } at		\$
{ Red }		
{ Asphalt }		
Lead Joints at		\$
Leadite Joints at		\$
5 Hrs. Foreman ^{Lead} at 6 1/2		\$ 3.13
8 Hrs. Common ^{Tapper} Labor at 50		\$ 4.00
14 Hrs. Common Labor at 45		\$ 6.30
Hrs. Mason at		\$
Hrs. Masons Helper at		\$
Hrs. Compressor at		\$
Compensation Ins		\$ 41
Trucking		\$ 1-
Builders Use of Water ^{Patch}		\$ 5-
Total		\$ 27.35

Labor and Material Report

476 21 Jan 15 1936
 21 Madison St

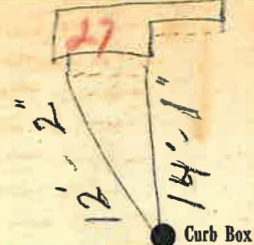

6" Main Elev of Main at tap 5'

Gate at ● TAX ID # 302.16-21-17 ● Gate at

● Curb Box

old Tap shut off at main

Handwritten initials