


LABOR AND MATERIALS

1	Copper	Connection	3/4"	\$ 3.08
Lead				
Same	Curb	Cock Valve T.S. & V.	1 in.	\$
1	Service box	} Short 3 1/2 x 4 1/2 Long 4 1/2 x 5 1/2 Buff. or Rdway		\$ 4.32
	Old returned			
8	Ft. 3/4 in.	} Copper C.I. C.I.	Pipe at 45	\$ 3.40
	Nipples	in. at		\$
1	Brass	1" to 3/4 in.	at	\$
1	Red'g	Male Adapter	3/4"	\$
1	Inc'g	Coupl'gs	to in. at	\$
	Union	in. at		\$
	Meter	in. at		\$
	Lead Joints	at		\$
	Compound Joints	at		\$
	Maintenance Foreman			\$
	Hrs. Water Maint. Man	1 at		\$
	Hrs. Water Maint. Man	2 at		\$
	Hrs. Garage Foreman	at		\$
	Hrs. Labor	at		\$
	Hrs. Compressor	at		\$
	Compensation Ins.	at \$ per C		\$
	Trucking			\$
	Pav't Patch			\$
	Tap by Larcav.			\$
	7-10-56.			\$
	O'head			\$

St. Madison ✓  
Pl. 30  
Ave. No. 30

Name of Owner Francis B. Lynch.

Labor and Mat'l. Report July 10 1956

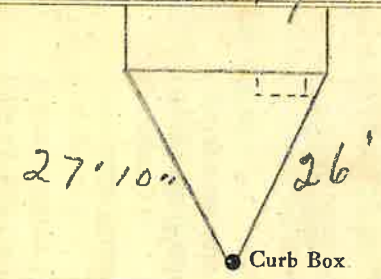

6" Main Elev. of Main at tap 4 1/2"  
Gate at • Gate at

• Curb Box

Before Paving.