


LABOR AND MATERIALS

1	Copper	Connection	3/4"	\$	308
1	Lead	Cock	3/4 in.	\$	389
1	Curb	Valve	3/4 in.	\$	
		T. S. & V.		\$	
1	Service box	Short 3 1/2 x 4 1/2		\$	432
	Old returned	Long 4 1/2 x 5 1/2		\$	
		Buff. or Rdway		\$	
11	Ft. 3/4 in.	Copper	Pipe at 45	\$	495
		G.I.		\$	
		G.I.		\$	
1	Nipples	3/4 in. at	Cl. galv.	\$	
	Bushings	to in. at		\$	
	Red'g	galv.		\$	
	Ine'g	Coupl'gs 1/4 to 3/4 in. at		\$	
	Union	in. at		\$	
	Meter	in. at		\$	
	Lead Joints at			\$	
	Compound Joints at			\$	
	Maintenance Foreman			\$	
	Hrs. Water Maint. Man-1 at			\$	
	Hrs. Water Maint. Man-2 at			\$	
	Hrs. Garage Foreman at			\$	
	Hrs. Labor at			\$	
	Hrs. Compressor at			\$	
	Compensation Ins. at \$ 5.686 per C			\$	
	Trucking			\$	150
	Pav't Patch			\$	
	Tap by Giggord & Co.			\$	
	7-19-56			\$	
	O'head			\$	

St. Madison
 Ave. No. 7

Name of Owner
Ray E. Streeter.

Labor and Mat'l. Report July 19 1956

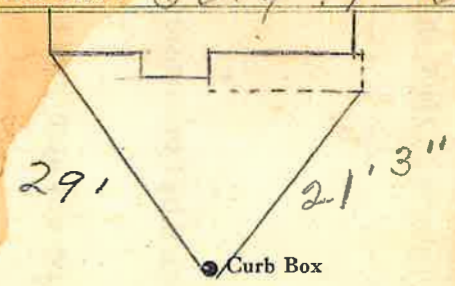

6" Main Elev. of Main at tap 5'
 Gate at • Gate at •

TAX ID # 302.20-10-17

• Curb Box

Before Paving.