

LSM-5C-6-1-45

8AB
Madison

33'-6" 30'-2"
Curb Box

Gate at ● Gate at ●

Elev. of Main at tap Main

32'-3" 26'-3"
Curb Box

See Below

Labor and Mat'l. Report Oct 25 1946

Name of Owner

St. Madison Ave. No. 4-4 1/2

8AB

LSM-5C-6-1-45

8AB

St. Madison Ave. No. 4-4 1/2

Name of Owner

Labor and Mat'l. Report Oct 25 1946

See Below

32'-3" 26'-3"
Curb Box

TAX ID # 302.20-9-2

Gate at ● Gate at ●

Elev. of Main at tap Main

33'-6" 30'-2"
Curb Box

Madison # 8AB

Labor and Materials

1	Lead Connection	3/4"	\$.
1	Curb Cock	3/4"	\$.
1	Service Box	(Short 3 1/2 x 4)	\$.
	Old returned	(Buffalo)	\$.
22	Ft. 3/4 in. G. I. Pipe at	Copper	\$.
20	Nipples	in. at	\$.
	Bushings	to in. at	\$.
1	Red'g Coup	to in. at	\$.
	Inc'g Coup	to in. at	\$.
	Union	in. at	\$.
	Meter	in. at	\$.
	Cu. Yds. Br. Stone at		\$.
	Cu. Yds. Sand at		\$.
	Bags Cement at		\$.
	Paving Brick	{ Mack Red Asphalt } at	\$.
2	Hrs. Foreman at		\$.
19	Hrs. Common Labor at		\$.
	Hrs. Mason at		\$.
	Hrs.	at	\$.
	Hrs.	at	\$.
20	Builders' Use of Water		\$.
	7.8.100	at	\$.
		at	\$.
		at	\$.
		at	\$.
	Total	\$.	18.81

Labor and Material Report

1925

June 9
4-4 1/2 Madison St



6"
Main

Elev. of
Main at tap

4 1/2'

Gate at ●

● Gate at

● Curb Box

~~Gate at~~
~~Main~~

LABOR AND MATERIALS


Copper } Connection \$
 Curb } Clock Valve } in. \$
 } T. S. & V. }
 Service box } Short 3 1/2 X 4 1/2 }
 Old returned } Long 4 1/2 X 5 1/2 }
 } Buff or Rdway } \$
 Ft. in. } Copper } Pipe at \$
 } Cast Iron }
 } Cast Iron }
 Nipples in. at \$
 Bushings to in. at \$
 Red'g } Couplings to in. at \$
 Inc'g }
 Union in. at \$
 Meter in. at \$
 Lead Joints at \$
 Compound Joints at \$
 Hrs. Foreman at \$
 Hrs. Chauffeur at \$
 Hrs. Tapper at \$
 Hrs. Labor at \$
 Hrs. Labor at \$
 Hrs. Compressor at \$
 Compensation Ins. \$
 Trucking \$
 Builders Use of Water \$
 \$
 \$
Madison

St. *848*
 Pl.
 Ave. No. *4-4 1/2*

Name of Owner

Labor and Mat'l. Report *Oct 25* 19*46*

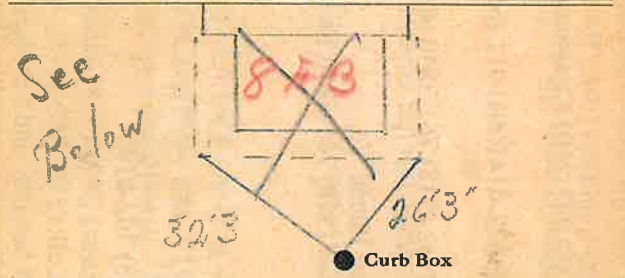

Main Elev. of Main at tap
 Gate at ● Gate at ●

