

LABOR AND MATERIALS

1	Copper Lead } Connection	3/4	\$	1.70
1	Curb { Cock Valve T.S. & V.	3/4 in.	\$	1.96
1	Service Box Old returned	{ Short 3 3/4 x 4 1/2 Long 4 1/2 x 5 1/2 Buffer Rdway }	\$	1.82
11	Ft. 3/4 in.	{ Copper Galv. Iron Cast Iron } Pipe at 19	\$	2.66
	Nipples	in. at	\$	
	Bushings	to in. at	\$	
	Red'g Inc'g } Couplings	to in. at	\$	
	Union	in. at	\$	
	Meter	in. at	\$	
	Lead Joints	at	\$	
	Leadite Joints	at	\$	
6	Hrs. Foreman	at	\$	
6	Hrs. Chauffeur	at 2 9 3/4	\$	4.13
	Hrs. Tapper	at	\$	
6	Hrs. Labor	at 6.00	\$	3.60 37.75
	Hrs. Labor	at	\$	
	Hrs. Compressor	at	\$	
	Compensation Ins.	2.669	\$.21
	Trucking		\$	1.27
	Builders Use of Water		\$	5.85
	Tap by Warsinski		\$	
	old to be dug up		\$	
			\$	
			\$	
			\$	73.03

23 1/4 44

Madison


St. 9
Pl. 5
Ave. No. 5

Name of Owner

Stafford

Labor and Mat'l. Report

Oct 11 1944

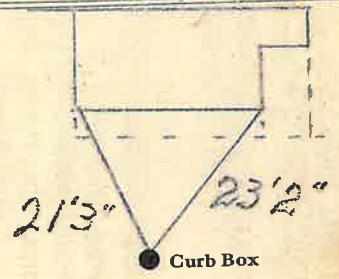

6" Main

Elev. of Main at tap 5

Gate at ●

● Gate at

● Curb Box