

Labor and Materials


1	Copper	Connection	3/4	\$ 3.20
	Lead			
1	Curb	Cock Valve	3/4 in.	\$ 3.00
		T. S. & V.		
1	Service Box	Short 3" x 4"		\$ 1.20
	Old returned	Long 4" x 6"		
		Buff. or Rdway		
21	Ft.	3/4 in. Copper		\$ 4.18
19		Galv. Iron		
		Cast Iron		
	Nipples	in. at		\$
	Bushings	to in. at		\$
1	Red'g	Couplings	to in. at	\$
	Inc'g			
	Union	in. at		\$
	Meter	in. at		\$
	Lbs Br. Stone	at		\$
	Lbs. Sand	at		\$
	Bags Cement	at		\$
	Paving Brick	Mack Red Asphalt	at	\$
	Lead Joints	at		\$
	Leadite Joints	at		\$
3	Hrs. Foreman	at	6.25	\$ 1.87
9	Hrs. Common Labor	at	50	\$ 4.50
7	Hrs. Common Labor	at	40 5/8	\$ 2.85
	Hrs. Mason	at		\$
	Hrs. Mason's Helper	at		\$
	Hrs. Compressor	at		\$
	Compensation Ins.			\$ 2.50
	Trucking			\$ 12.00
	Builders' Use of Water			\$
Total				\$ 22.125

26-50

14

Labor and Material Report June 8, 1926

no 10 Madison St

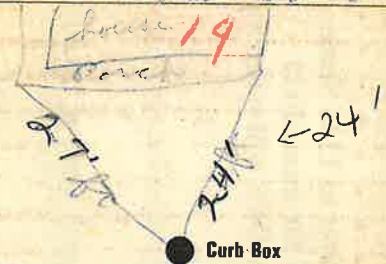

6"
" Main

Elev. of Main at tap 4 1/2'

Gate at ● Gate at ●

● Curb Box