

LABOR AND MATERIALS

Copper	} Connection	_____	\$ _____	
Lead				
Curb	} Cock	} _____ in.	\$ _____	
				} Valve
Service box	} Short 3½ x 4½	} _____	\$ _____	
				Old returned
Ft. _____ in.	} { Copper G. I. C. I. }	Pipe at _____	\$ _____	
Nipples _____ in.		at _____	\$ _____	
Bushings _____ to _____ in.	at _____	\$ _____		
Red'g } Inc'g }	} Coupl'gs _____ to _____ in.	at _____	\$ _____	
Union _____ in.				at _____
Meter _____ in.	at _____	\$ _____		
_____			\$ _____	
Compound Joints	at _____	\$ _____		
Maintenance Foreman	_____	\$ _____		
Hrs. Water Maint. Man-1	at _____	\$ _____		
Hrs. Water Maint. Man-2	at _____	\$ _____		
Hrs. Garage Foreman	at _____	\$ _____		
Hrs. Labor- _____	at _____	\$ _____		
Hrs. Compressor	at _____	\$ _____		
_____			\$ _____	
Trucking _____		\$ _____		
Pav't Patch _____		\$ _____		
_____		\$ _____		
_____		\$ _____		

QUEENS BURY HOTEL

MAPLE

St. _____
Pl. _____
Ave. No. 50

Name of Owner _____

Labor and Mat'l. Report 19 _____

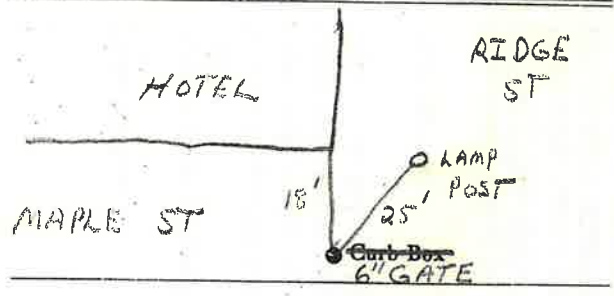

Main _____ Elev. of Main at tap _____
Gate at • _____ Gate at • _____

• Curb Box