

LABOR AND MATERIALS

1	Copper Lead	Connection	1 1/2"	\$
1	Curb	Cock Valve T.S. & V.	2 in. Oriseal	\$
1	Service box	Short 3 1/2 x 4 1/2	5'-box	
	Old returned	Long 4 1/2 x 5 1/2	2'-EXT.	
		Buff or Rdway	7"	\$
25	Ft. 2 in.	Copper Pipe at		\$
		G.I.		\$
		C.I.		\$
1	Nipples	2 in. at	Brass L	\$
	Bushings	to in. at		\$
1	Red'g Inc'g	Coupl'gs	2" to 2 in. at	\$
			2" cap. to cap.	
1	Union	2 in. at	male adapter	\$
	Meter	in. at		\$
	Lead Joints	at		\$
	Compound Joints	at		\$
	Maintenance Foreman			\$
	Hrs. Water Maint. Man	1 at		\$
	Hrs. Water Maint. Man	2 at		\$
	Hrs. Garage Foreman	at		\$
	Hrs. Labor	at		\$
	Hrs. Compressor	at		\$
	Compensation Ins.	at \$ per C		\$
	Trucking			\$
	Pav't Patch			\$
	Tap by Giggord & Co			\$
			5-17-63	\$
	O'head			\$

Maple St. - Pl. - Ave. No. 93

Name of Owner St. Mary's Convent.

Labor and Mat'l. Report May 17 19 63

6" C.I. Main Elev. of Main at tap 5 1/2"

Gate at • Gate at •

TAX ID # 303.17-16-16

• Curb Box

LSM-5C-8-10-61

LABOR AND MATERIALS

Copper	} Connection	_____	\$ _____		
Lead					
Curb	} Cock Valve T. S. & V.	} _____ in.	\$ _____		
Service box	} Short 3 1/2 x 4 1/2	} _____	\$ _____		
Old returned				Long 4 1/2 x 5 1/2	
				Buff or Rdway	
Ft. _____ in.	} Copper G. I. C. I.	} Pipe at _____	\$ _____		
Nipples _____ in.	at _____		\$ _____		
Bushings _____	to _____ in.	at _____	\$ _____		
Red'g Inc'g } Coupl'gs _____	to _____ in.	at _____	\$ _____		
Union _____	in.	at _____	\$ _____		
Meter _____	in.	at _____	\$ _____		
Lead Joints at _____			\$ _____		
Compound Joints at _____			\$ _____		
Maintenance Foreman _____			\$ _____		
Hrs. Water Maint. Man—1 at _____			\$ _____		
Hrs. Water Maint. Man—2 at _____			\$ _____		
Hrs. Garage Foreman _____ at _____			\$ _____		
Hrs. Labor— _____ at _____			\$ _____		
Hrs. Compressor at _____			\$ _____		
Compensation Ins. at \$ _____ per C _____			\$ _____		
Trucking _____			\$ _____		
Pav't Patch _____			\$ _____		
_____			\$ _____		
_____			\$ _____		
_____			\$ _____		
O'head _____			\$ _____		
			\$ _____		


St. Pl. Ave. No. 93

MAPLE

Name of Owner

ST. MARY'S CONVENT

Labor and Mat'l. Report 19

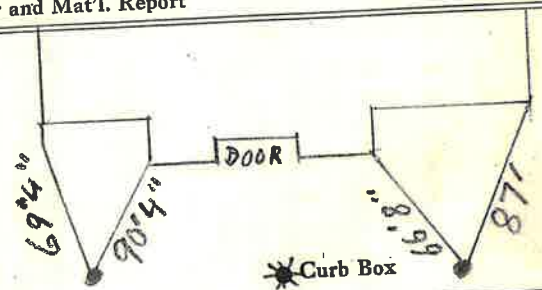

\_\_\_\_\_ Main Elev. of Main at tap \_\_\_\_\_  
 Gate at ● Gate at ●

● Curb Box  
 BOTH SERVICES SHUT OFF  
 4/30/65 BY MILLER & KENNY