

Labor and Materials

1	Copper	Lead	Connection	3/4"	\$ 2.60
1	Curb	Cock Valve	T. S. & V.	3/4" in.	\$ 2.30
1	Service Box	Short	3/4" x 4 1/2"		\$ 1.40
	Old returned	Long	4 1/2" x 5 1/2"	Buff. or Rdway	
11	Ft.	3/4" in.	Copper Galv. Iron	Pipe at	\$ 2.92
	Nipples		in. at		\$
	Bushings		to in. at		\$
	Red'g Inc'g	Couplings	to in. at		\$
	Union		in. at		\$
	Meter		in. at		\$
	Lbs. Br. Stone		at		\$
	Lbs. Sand		at		\$
	Bags Cement		at		\$
	Paving Brick	Mack Red Asphalt	at		\$
	Lead Joints		at		\$
	Leadite Joints		at		\$
2	Hrs.	Foreman	at		\$ 1.25
16	Hrs.	Common Labor	at		\$ 6.50
	Hrs.	Common Labor	at		\$
	Hrs.	Mason	at		\$
	Hrs.	Mason's Helper	at		\$
	Hrs.	Compressor	at		\$
	Compensation	Ins			\$.21
	Trucking				\$ 1.00
	Builders' Use of Water	Patch			\$ 5.00
Total \$					23.17


Labor and Material Report

19 27

29-45

109
37

Maple St.

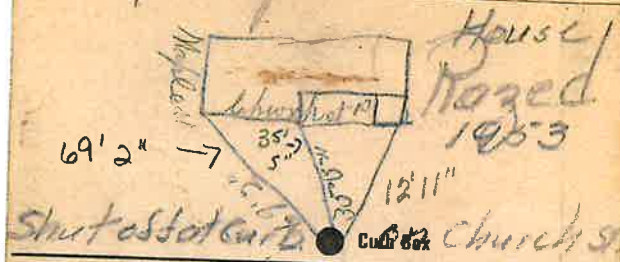

Main

Elev of Main at tap

Gate at

Curb Box

This Place Razed

Shut off at Curb