

LABOR AND MATERIALS

1	Copper Lead	Connection	$\frac{3}{4}$ "	\$
1	Curb	Cock Valve T.S. & V.	$\frac{3}{4}$ " in. Oriseal	\$
1	Service box	Short $3\frac{1}{2}$ x $4\frac{1}{2}$		
1	Old returned	Long $4\frac{1}{2}$ x $5\frac{1}{2}$		
		Buff or Rdway		\$
20	Ft.	$\frac{3}{4}$ in. { Copper C.I. C.I. }	Pipe at	\$
	Nipples	in. at		\$
	Bushings	to in. at		\$
	Red'g Inc'g	Coupl'gs to in. at		\$
	Union	in. at		\$
	Meter	in. at		\$
	Lead Joints	at		\$
	Compound Joints	at		\$
	Maintenance Foreman			\$
	Hrs. Water Maint. Man-1	at		\$
	Hrs. Water Maint. Man-2	at		\$
	Hrs. Garage Foreman	at		\$
	Hrs. Labor	at		\$
	Hrs. Compressor	at		\$
	Compensation Ins.	at \$ per C		\$
	Trucking			\$
	Pav't Patch			\$
	Tap by Giggord & Co.			\$
	O'head			\$


St. ~~Pl.~~  
Ave. No. 121

Maple

Name of Owner

Quinn

Labor and Mat'l. Report June 16 1965

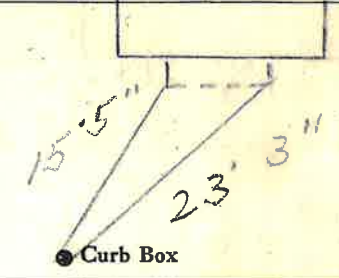

Galv. Center St.

4" Main

Elev. of Main at tap 5'

Gate at • Tap on Center St. • Gate at

• Curb Box

See Card for  
22 A+B Center St.

Maple St.