

LABOR AND MATERIALS

1	Copper Lead	Connection	3/4"		\$ 3.04
1	Curb	Cock Valve F.S. & V.	3/4 in.		\$ 3.54
1	Service box	Short 3 1/2 x 4 1/2			
	Old returned	Long 4 1/2 x 5 1/2			
		Buff or Rdway			\$ 4.70
26	Ft.	Copper			
	3/4 in.	G.I.			
		G.I.			
		Pipe at	35		\$ 9.10
	Nipples	in. at			\$
	Bushings	to in. at			\$
	Red'g Inc'g	Coupl'gs to in. at			\$
	Union	in. at			\$
	Meter	in. at			\$
	Lead Joints at				\$
	Compound Joints at				\$
	Hrs. Water Maint. Man-1 at				\$
	Hrs. Water Maint. Man-2 at				\$
4	Hrs. Labor	AM at 1.26			\$ 5.04
22	Hrs. Labor	at 1.02			\$ 22.44
3	Hrs. Compressor at	1.50			\$ 4.50
	Compensation Ins. at \$	7.66 per C.			\$.73
	Trucking				\$ 1.00
	Pav't Patch				\$ 26.88
					\$
					\$
					\$
	O'head				\$

27.95

Tap made by Gifford \$ 80.97
4-12-51


15-1951

Maple

St. PL- Ave. No. 135

Name of Owner
Marzola

Labor and Mat'l. Report 4-12- 1951

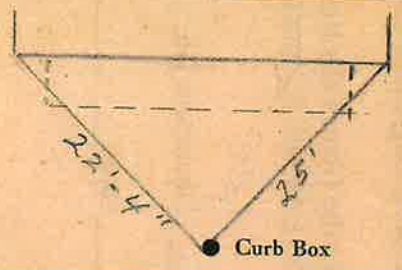

6" Main Elev. of Main at tap 5'

Gate at ● Gate at ●

● Curb Box