




# 138

Maplest

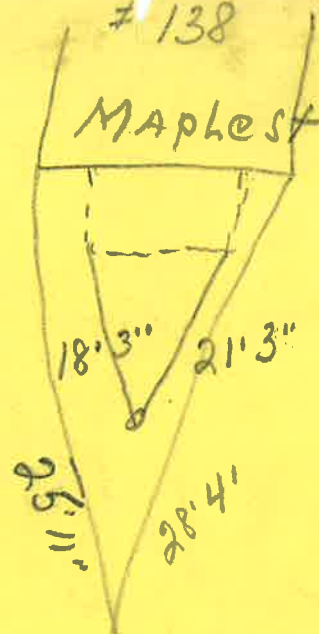

8' 3/4" G.I.