

### Labor and Materials


Copper	Lead	Connection	.....	\$ 2.70		
Curb	{	Cock Valve T.S. & V.	in.....	\$ 2.31		
Service Box	{	Short 3/4x1/2	}.....	\$ 1.45		
Old returned		Long 1/2x5/8		Buff. or Rdway		
7 Ft.	3/4 in.	{	Copper Galv. Iron Cast Iron	Pipe at.....	\$ 1.89	
Nipples	.....	in. at.....		\$		
Bushings	.....	to 1/2 in. at.....		\$ .10		
Red'g Inc'g	{	Couplings	.....	to.....	in. at.....	\$
Union				.....	in. at.....	
Meter	.....	in. at.....		\$		
Lbs. Br. Stone	at.....			\$		
Lbs. Sand	at.....			\$		
Bags Cement	'at.....			\$		
Paving Brick	{	Mack Red Asphalt	} at.....		\$	
Lead Joints				at.....		\$
Leadite Joints				at.....		\$
2 Hrs.	Foreman	at.....		\$ 1.25		
11 Hrs.	Common Labor	at Tapper @ 50		\$ 5.50		
5 Hrs.	Common Labor	at.....		\$ 2.25		
Hrs	Mason	at.....		\$		
Hrs	Mason's Helper	at.....		\$		
2 Hrs.	Compressor	at.....		\$ 3.00		
Compensation	Ins.....			\$ .28		
Trucking	.....			\$ 1.00		
Builders' Use of Water	Patch	.....		\$ 25.00		
Total				\$ 46.81		

30-185

Labor and Material Report

1930

140 Maple Street

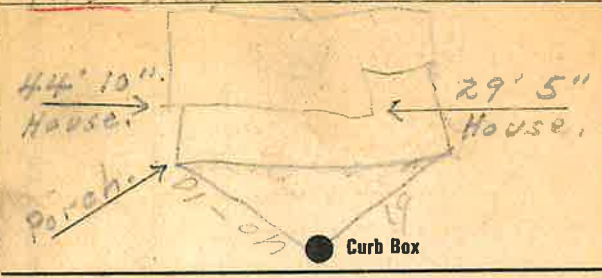

6 Main

Elev of Main at tap 5 1/2

Gate at ●

● Gate at

● Curb Box

old tap disconnected