


Labor and Materials

1	Copper } Connection <i>3/4"</i>	\$ 2.70	
	Lead		
1	Curb } Cock } <i>3/4"</i> in.	\$ 2.39	
	Valve } T.S. & V.		
1	Service Box } Short <i>3/4" x 1/2"</i>	\$ 1.45	
	Old returned } Long <i>1 1/2" x 5/8"</i> Buff. or Rdway		
21	Ft. <i>3/4"</i> in. } Copper } Pipe at	\$ 5.67	
	Nipples in. at	\$	
	Bushings to in. at	\$	
	Red'g } Couplings to in. at	\$	
	Inc'g }		
	Union in. at	\$	
	Meter in. at	\$	
	Lbs. Br. Stone at	\$	
	Lbs. Sand at	\$	
	Bags Cement 'at	\$	
	Paving Brick } Mack } at	\$	
	Asphalt }		
	Lead Joints at	\$	
	Leadite Joints at	\$	
3	Hrs. Foreman at	\$ 1.88	
16	Hrs. Common Labor at	\$ 7.20	
	Hrs. Common Labor at	\$	
	Hrs. Mason at	\$	
	Hrs. Mason's Helper at	\$	
	Hrs. Compressor at	\$	
	Compensation Ins	\$ 2.8	
	Trucking	\$ 1.-	
	Builders' Use of Water <i>Patch</i>	\$ 25.-	
	Total \$ <i>47.57</i>		

30-85

Labor and Material Report *May 29* 19 *30*

3/4" top of 53455 Maple at

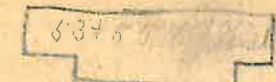

26' 11" ← 26' 2"

6" Main Elev of Main at tap *44'*

Gate at *21' to MAIN* Gate at

Old sheet ● Curb Box