


Labor and Materials

1	Copper } Connection $\frac{3}{4}$ "	\$ 3.20
	Lead }	
1	Curb } Cock } $\frac{3}{4}$ " in.	\$ 1.00
	Service Box } Short $3\frac{1}{2} \times 4\frac{1}{2}$	\$ 1.30
	Old returned } Long $4\frac{1}{2} \times 5\frac{1}{2}$	
17	Ft. $\frac{3}{4}$ " in. } Copper } Pipe at	\$ 27.4
	Nipples..... in. at.....	\$
	Bushings..... to..... in. at.....	\$
	Red'g } Couplings..... to..... in. at.....	\$
	Inc'g }	
	Union..... in. at.....	\$
	Meter..... in. at.....	\$
	Lbs. Br. Stone at.....	\$
	Lbs. Sand at.....	\$
	Bags Cement at.....	\$
	Paving Brick } Mack } at.....	\$
	Lead Joints at.....	\$
	Leadite Joints at.....	\$
4	Hrs. Foreman at..... $92\frac{1}{2}$	\$ 25.0
10	Hrs. Common Labor at..... $40\frac{5}{8}$	\$ 20.6
	Hrs. Common Labor at.....	\$
	Hrs. Mason at.....	\$
	Hrs. Mason's Helper at.....	\$
	Hrs. Compressor at.....	\$
	Compensation Ins.....	\$ 17
	Trucking.....	\$ 1.00
	Builders' Use of Water.....	\$
Total		\$ 6.97

Labor and Material Report

July 14 1928

$\frac{3}{4}$ " top at Maple at

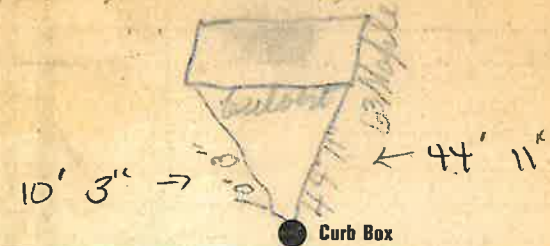

4" gate Main Elev. of Main at tap 4/3

Gate at ● Gate at ●

● Curb Box