


Labor and Materials

1	Lead Connection		\$
1	Curb Cock		\$
1	Service Box (Short 3 1/2 x 4 1/2)		\$
	Old returned (Long 4 1/2 x 5 1/2)		\$
8	Ft. 3/4 in. G. I. Pipe at		\$
	Nipples	in. at	\$
	Bushings	to in. at	\$
	Red'g Coup	to in. at	\$
	Inc'g Coup	to in. at	\$
	Union	in. at	\$
	Meter	in. at	\$
	Cu. Yds. Br. Stone at		\$
	Cu. Yds. Sand at		\$
	Bags Cement at		\$
	Paving Brick (Mack Red Asphalt) at		\$
3	Hrs. Foreman at		\$
14	Hrs. Common Labor at		\$
	Hrs. Mason at		\$
	Hrs.	at	\$
	Hrs.	at	\$
20	Builders' Use of Water		\$
		at	\$
	Truck 100	at	\$
	Pavement	at	\$
		at	\$
	Total	\$	

Labor and Material Report

19 21

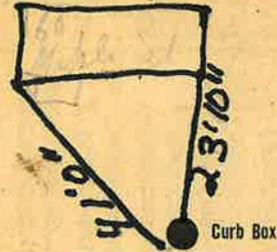

6" Main

Elev. of Main at tap

Gate at ●

● Gate at

TAX ID # 303.17-11-28

● Curb Box