


Labor and Materials

Copper } Connection.....	3	\$ 2.70
Lead }	3	
Curb } Cock Valve }	3	\$ 2.39
} T.S. & V. }	3	
Service Box } Short 3/4 x 1/2 }		\$ 1.45
Old returned } Long 4/8 x 5/8 }		
} Buff. or Rdway }		
7 Ft. } in. } Copper } Pipe at.....	3	\$ 1.89
} Galv. Iron }	3	
} Cast Iron }	3	
Nipples..... in. at.....		\$
Bushings..... to 1/2 in. at.....	3	\$ 1.0
Red'g } Couplings..... to..... in. at.....		\$
Inc'g }		
Union..... in. at.....		\$
Meter..... in. at.....		\$
Lbs. Br. Stone at.....		\$
Lbs. Sand at.....		\$
Bags Cement 'at.....		\$
Paving Brick } Mack } at.....		\$
} Red }		
} Asphalt }		
Lead Joints at.....		\$
Leadite Joints at.....		\$
4 1/2 Hrs. Foreman at.....		\$ 2.81
1 Hrs. Common Labor at Tapper @ .50		\$.50
1.3 Hrs. Common Labor at.....		\$ 5.85
Hrs Mason at.....		\$
Hrs Mason's Helper at.....		\$
2 Hrs. Compressor at.....		\$ 3.-
Compensation Ins.....		\$.28
Trucking.....		\$ 1.-
Builders' Use of Water Patch		\$ 2.5-
Total \$		46.97

30-188

Maple Street 154-B
(154A)

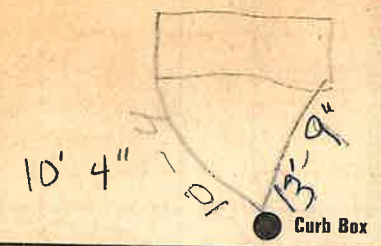

Main Elev of Main at tap 52

Gate at ● ● Gate at

● Curb Box

Shoe shop Maple St.
New Tap