


## LABOR AND MATERIALS

Copper } Connection	.....	\$	
Lead } Connection	.....	\$	
Curb { Clock Valve } { T. S. & V. } .....	..... in.	\$	
Service box } Short 3 1/2 X 4 1/2 } Old returned } Long 4 1/2 X 5 1/2 } } Buff or Rdway }	.....	\$	
Ft. .... in. } Copper } } Galv. Iron } } Cast Iron }	..... Pipe at	\$	
Nipples .....	in. at	\$	
Bushings .....	to .....	in. at	\$
Red'g } Inc'g } Couplings .....	to .....	in. at	\$
Union .....	in. at	\$	
Meter .....	in. at	\$	
Lead Joints at .....		\$	
Compound Joints at .....		\$	
Hrs. Foreman at .....		\$	
Hrs. Chauffeur at .....		\$	
Hrs. Tapper at .....		\$	
Hrs. Labor at .....		\$	
Hrs. Labor at .....		\$	
Hrs. Compressor at .....		\$	
Compensation Ins. ....		\$	
Trucking .....		\$	
Builders Use of Water .....		\$	
Measure by Wapsi's sk +		\$	
Gen		\$	
.....		\$	
.....		\$	
.....		\$	
.....		\$	

St.  
Pl.  
Ave. No. 18

Name of Owner .....

Labor and Mat'l. Report June 1945

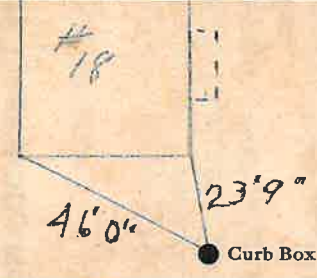

Main Elev. of  
Main at tap .....

Gate at ● ● Gate at

● Curb Box