


Labor and Materials

Copper	} Connection		\$ 2.70
Lead			
Curb	} Cock Valve T. S. & V.	in.	\$ 2.39
Service Box	} Short 3/4x4 1/2		\$ 1.45
Old returned		Long 4x5 1/2	
		Buff or Rdway	
2.4 Ft.	} Copper Galv. Iron Cast Iron	in.	\$ 6.48
			Pipe at
Nipples		in. at	\$
Bushings		to in. at	\$
Red'g Inc'g	} Couplings	to in. at	\$
Union		in. at	\$
Meter		in. at	\$
Lbs. Br. Stone		at	\$
Lbs. Sand		at	\$
Bags Cement		at	\$
Paving Brick	} Mack Red Asphalt	at	\$
Lead Joints		at	\$
Leadite Joints		at	\$
4 Hrs. Foreman		at	\$ 2.50
Hrs. Common Labor		at	\$
1.4 Hrs. Common Labor		at	\$ 6.30
Hrs. Mason		at	\$
Hrs. Mason's Helper		at	\$
2 Hrs. Compressor		at	\$ 3 -
Compensation Ins			\$ 27
Trucking			\$ 1 -
Builders' Use of Water	Patch		\$ 25 -
Total			\$ 51.09

30-143
Labor and Material Report July 24 1930

155 9th St

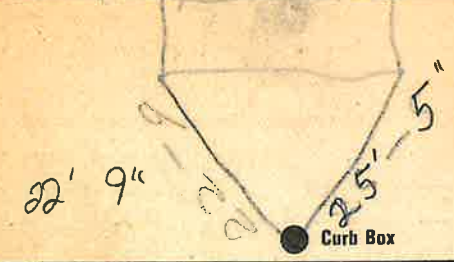

6 Main Eley of Main at tap 6

Gate at ● Gate at ●

● Curb Box

old tap disconnected

Disconnected at main.

5-21-64

This Place Razed. 5-14-64

Pipe Broken by Contractor laying gas main.