

LABOR AND MATERIALS

Copper	} Connection	_____	\$ _____			
Lead						
Curb	} Cock	_____ in.	\$ _____			
				} Valve		
						} T. S. & V.
Service box	} Short 3 1/2 x 4 1/2	_____	\$ _____			
Old returned				} Long 4 1/2 x 5 1/2		
Ft. _____ in.	} Copper	} Pipe at _____	\$ _____			
				} G. I.		
Nipples _____ in.	at _____	\$ _____				
Bushings _____ to _____ in.	at _____	\$ _____				
Red'g } Inc'g	} Coupl'gs _____ to _____ in.	at _____	\$ _____			
Union _____ in.				at _____	\$ _____	
Meter _____ in.	at _____	\$ _____				
Lead Joints	at _____	\$ _____				
Compound Joints	at _____	\$ _____				
Maintenance Foreman	_____	\$ _____				
Hrs. Water Maint. Man - 1	at _____	\$ _____				
Hrs. Water Maint. Man - 2	at _____	\$ _____				
Hrs. Garage Foreman	at _____	\$ _____				
Hrs. Labor - _____	at _____	\$ _____				
Hrs. Compressor	at _____	\$ _____				
Compensation Ins: at \$ _____	per C _____	\$ _____				
Trucking	_____	\$ _____				
Pav't Patch	_____	\$ _____				
_____		\$ _____				
_____		\$ _____				
_____		\$ _____				
O'head	_____	\$ _____				

NEW CURB STOP & BOX  
INSTALLED. 4-6-2001

COPPER - 3/4"


St. \_\_\_\_\_  
Pl. \_\_\_\_\_  
Ave. No. 157

Name of Owner

Maple  
Davey's Rest + Bar

Measured in

Labor and Mat'l. Report Mar. 24 1960

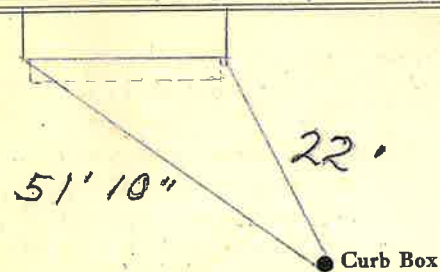

● Curb Box

6" Main

Elev. of Main at tap 5'

Gate at ●

● Gate at

● Curb Box