


LABOR AND MATERIALS

1 Copper } Connection 6" Tapping sleeve \$
 Lead }
 1 Curb } Cock Valve } 6 in. Valve \$
 T. S. & V. }
 1 Service box { Short 3 1/2 x 4 1/2 }
 - Old returned { Long 4 1/2 x 5 1/2 }
 { Buff or Rdway } \$
 35 Ft. 6 in. { Copper } Pipe at \$
 { C. I. }
 Nipples in. at \$
 Bushings to in. at \$
 Red'g }
 Inc'g } Coupl'gs to in. at \$
 Union in. at \$
 Meter in. at \$
 Lead Joints at \$
 Compound Joints at \$
 Maintenance Foreman \$
 Hrs. Water Maint. Man-1 at \$
 Hrs. Water Maint. Man-2 at \$
 Hrs. Garage Foreman at \$
 Hrs. Labor at \$
 Hrs. Compressor at \$
 Compensation Ins. at \$ per C \$
 Trucking \$
 Pav't Patch \$
 Tap by Lareau & Co \$
 Nov. 19-23-68 \$
 O'head \$
 \$

Maple St. Pl. Ave. No. 160
 Name of Owner

Finch, Pruyn & Co.

Labor and Mat'l. Report Nov. 19-23 1968

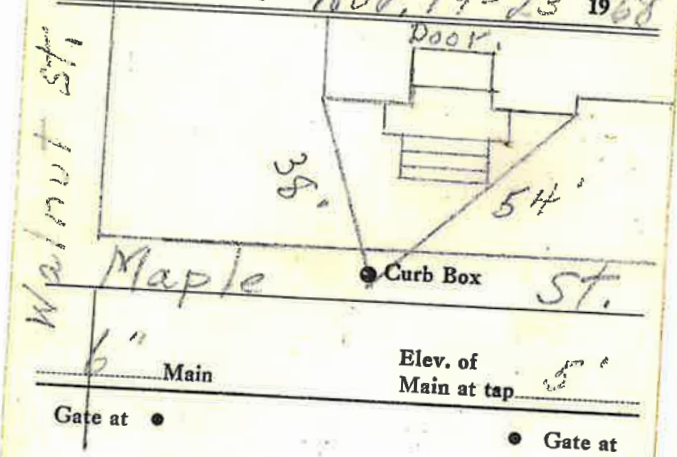

6" Main Elev. of Main at tap 5'
 Gate at • Gate at •

• Curb Box
 6" Sprinkler System
 Tap.

TAX ID # 303.17-12-16

LABOR AND MATERIALS


1	Copper } Connection	\$	
	Lead }	\$	
1	Curb } Cock Valve	3/4	in.	\$
	T. S. & V. }			
	Service Box	Short 3 1/2 x 4 1/2		\$
	Old returned	Long 4 1/2 x 5 1/2		\$
		Buffer Rdway		\$
27'	Ft. / in.	Copper	} Pipe at	\$
		Galv Iron		
		Cast Iron		
	Nipples	in. at	\$	
	Bushings	to in. at	\$	
	Red'g } Couplings	to in. at	\$	
	Inc'g }			
	Union	in. at	\$	
	Meter	in. at	\$	
	Lead Joints at		\$	
	Leadite Joints at		\$	
	Hrs. Foreman at		\$	
	Hrs. Chauffeur at		\$	
	Hrs. Tapper at		\$	
	Hrs. Labor at		\$	
	Hrs. Labor at		\$	
	Hrs. Compressor at		\$	
	Compensation Ins.		\$	
	Trucking		\$	
	Builders Use of Water		\$	
	<i>This place had a</i>			
	<i>leak on their</i>			
	<i>side. CUT IN</i>			
	<i>New 3/4" curb</i>			
	<i>stop 12-6-57</i>			

Maple

St. ~~St.~~
Ave. No. 160

Name of Owner

Labor and Mat'l. Report AUG 25 1939

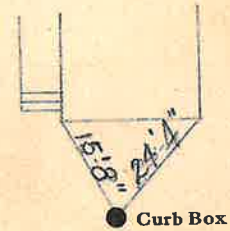

Tap on

Main *valve at* Elev. of Main at tap

Gate at ●

● Gate at

● Curb Box

Domestic Tap.