

LABOR AND MATERIALS

Copper	}	Connection		\$	
Lead					
Curb	}	Cock	} in.	\$	
		Valve			
		T. S. & V.			
Service box	}	Short $3\frac{1}{2} \times 4\frac{1}{2}$	} \$		
Old returned		Long $4\frac{1}{2} \times 5\frac{1}{2}$			
		Buff or Rdway			
<u>31' 2"</u> 25 Ft. <u>1 1/2</u> in.	}	Copper	} Pipe at	\$	
		G.I.			
		C.I.			
Nipples	in. at			\$	
Bushings	to in. at			\$	
Red'g	}	Coupl'gs	to in. at	\$	
Inc'g					
Union	in. at			\$	
Meter	in. at			\$	
Lead Joints at				\$	
Compound Joints at				\$	
Maintenance Foreman				\$	
Hrs. Water Maint. Man—1 at				\$	
Hrs. Water Maint. Man—2 at				\$	
Hrs. Garage Foreman at				\$	
Hrs. Labor— at				\$	
Hrs. Compressor at				\$	
Compensation Ins. at \$		per C		\$	
Trucking				\$	
Pav't Patch				\$	
				\$	
				\$	
O'head				\$	
				\$	

St. 165 Maple
~~Pl.~~ Ave. No. 165


Name of Owner

M. Choppa

Labor and Mat'l. Report

10-1

1986

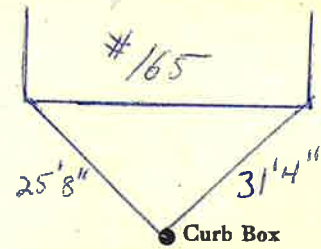

OAK ST

Main

Elev. of
Main at tap

Gate at ●

● Gate at

● Curb Box