

Labor and Materials


.....	Copper	}	Connection.....	\$			
.....	Lead		\$			
.....	Curb	}	Cock	}	}			
.....			Valve			in
.....			T. S. & V.		
.....	Service Box	}	Short	}	}			
.....	Old returned		3 1/2 x 4 1/2			\$	
.....			Long			4 1/2 x 5 1/2
.....			Buff. or Rdway		
.....	Ft.	}	Copper	} Pipe at	}			
.....	in.		Galv Iron			
.....			Cast Iron			
.....			
.....	Nipples		in. at	\$			
.....	Bushings		to	in. at	\$			
.....	Red'g	}	Conplings.....	to	in. at			
.....	Inc'g					\$
.....	Union		in. at	\$			
.....	Meter		in. at	\$			
.....	Lead Joints		at	\$			
.....	Leadite Joints		at	\$			
.....	Hrs. Foreman		at	\$			
.....	Hrs. Chauffeur		at	\$			
.....	Hrs. Tapper		at	\$			
.....	Hrs. Labor		at	\$			
.....	Hrs. Labor		at	\$			
.....	Hrs. Compressor		at	\$			
.....	Compensation Ins.		\$			
.....	Trucking		\$			
.....	Builders Use of Water		\$			
.....			\$			
.....			\$			
St.
Pl.
Ave. No. 178

Name of Owner

Labor and Mat'l. Report

19

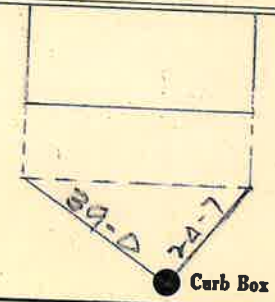

.....Main Elev. of
Main at tap.....

Gate at ● ● Gate at

● Curb Box

LABOR AND MATERIALS


1	Copper Lead	Connection	3/4"	\$
1	Curb	Cock Valve T. S. & V.	3/4" in.	\$
1	Service box Old returned	Short 3 1/2 x 4 1/2 Long 4 1/2 x 5 1/2 Buff or Rdway		\$
8	Ft.	3/4" in. { Copper G. I. C. I. }	Pipe at	\$
	Nipples	in. at		\$
	Bushings	to in. at		\$
	Red'g Inc'g	Coupl'gs to in. at		\$
	Union	in. at		\$
	Meter	in. at		\$
	Lead Joints	at		\$
	Compound Joints	at		\$
	Maintenance Foreman			\$
	Hrs. Water Maint. Man	1 at		\$
	Hrs. Water Maint. Man	2 at		\$
	Hrs. Garage Foreman	at		\$
	Hrs. Labor	at		\$
	Hrs. Compressor	at		\$
	Compensation Ins.	at \$ per C		\$
	Trucking			\$
	Pav't Patch			\$
	Tap by GIFFORD & CO.	6-20-61		\$
	O'head			\$

A

Maple St. -Pl- Ave. No. 178

Name of Owner Northern Dist. Co.

Labor and Mat'l. Report June 20 19

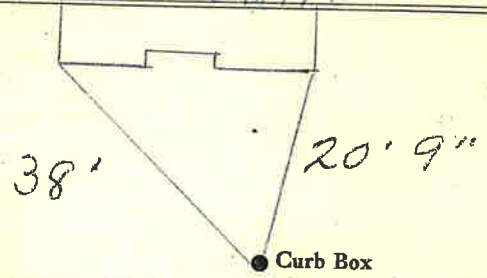

6" C.I. Main Elev. of Main at tap 5 1/2

Gate at • Gate at •
8' to MAIN

• Curb Box

3/4" Tap