


Labor and Materials

Copper	}	Connection.....	\$	
Lead					
Curb	}	Cock Valve T. S. & V.	in	\$	
Service Box					
Old returned					
	}	Short 3½ x 4½	\$	
		Long 4½ x 5½			
		Buff. or Rdway			
Ft. in.	}	Copper	Pipe at	\$	
		Galv Iron			
		Cast Iron			
Nipples	in. at	\$	
Bushings	to	in. at	\$	
Red'g	}	Conplings	to	in. at	\$
Inc'g					
Union.....	in. at	\$	
Meter.....	in. at	\$	
Lead Joints at			\$	
Leadite Joints at			\$	
Hrs. Foreman at			\$	
Hrs. Chauffeur at			\$	
Hrs. Tapper at			\$	
Hrs. Labor at			\$	
Hrs. Labor at			\$	
Hrs. Compressor at			\$	
Compensation Ins.			\$	
Trucking			\$	
Builders Use of Water			\$	
			\$	
			\$	
St.
Pl:
Ave. No. 180

Name of Owner Myrtle

Labor and Mat'l. Report 19

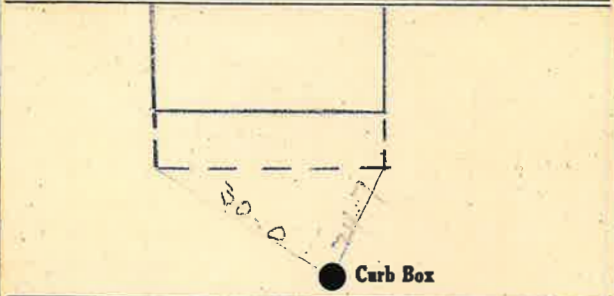

.....Main Elev. of Main at tap.....

Gate at ● ● Gate at

● Curb Box

30' 0" 24' 7"