


LABOR AND MATERIALS

1	Copper	Connection	3/4"	\$
1	Lead	Cock	3/4 in.	\$
1	Curb	Valve	3/4 in.	\$
		T.S. & V.		
1	Service box	Short 3 1/2 x 4 1/2		
	Old returned	Long 4 1/2 x 5 1/2		
		Buff or Rdway		\$
11	Ft. 3/4 in.	Copper	Pipe at	\$
		C.I.		
		C.I.		
	Nipples	in. at		\$
	Bushings	to in. at		\$
	Red'g	Coupl'gs	to in. at	\$
	Inc'g			
	Union	in. at		\$
	Meter	in. at		\$
	Lead Joints	at		\$
	Compound Joints	at		\$
	Maintenance Foreman			\$
	Hrs. Water Maint. Man-1	at		\$
	Hrs. Water Maint. Man-2	at		\$
	Hrs. Garage Foreman	at		\$
	Hrs. Labor	at		\$
	Hrs. Compressor	at		\$
	Compensation Ins. at \$	per C.		\$
	Trucking			\$
	Pay't Patch			\$
	Tap by Gifford & Co.			\$
	4-8-58			\$
	O'head			\$

V
Maple St. 182
Pl. Ave. No. 182
 Name of Owner Cole + Hanks

Labor and Mat'l. Report Apr. 8 1958

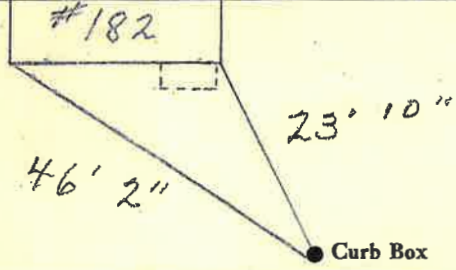

6" Galv. Main Elev. of Main at tap 5 1/2'
 Gate at • Gate at
11' to MAIN

● Curb Box

TAX ID # 303.17-13-15