


Labor and Materials

Copper	Connection	\$ 2.70	
Curb	Cock Valve T.S. & V. in.	\$ 2.39	
Service Box	Short 3" x 4 1/2"	}	\$ 1.55	
Old returned	Long 4 1/2" x 5 1/2"			
10 Ft.	Copper Galv. Iron Cast Iron	Pipe at	\$ 7.70	
Nipples in. at	\$	
Bushings to	in. at	\$	
Red'g Inc'g	Couplings to	in. at	\$
Union in. at	\$	
Meter in. at	\$	
Lbs. Br. Stone	at	\$	
Lbs. Sand	at	\$	
Bags Cement	at	\$	
Paving Brick	Mack Red Asphalt	at	\$	
Lead Joints	at	\$	
Leadite Joints	at	\$	
4 Hrs.	Foreman at	\$ 2.50	
18 Hrs.	Common Labor at	\$ 8.10	
Hrs.	Common Labor at	\$	
Hrs.	Mason at	\$	
Hrs.	Mason's Helper at	\$	
2 Hrs.	Compressor at	\$ 3.-	
Compensation	Ins	\$.33	
Trucking	\$ 1.-	
Builders' Use of Water	Patch	\$ 25.-	
Total \$			49.27	

30-182

Labor and Material Report *P.H. 21* 19 *70*

20 Maple Street

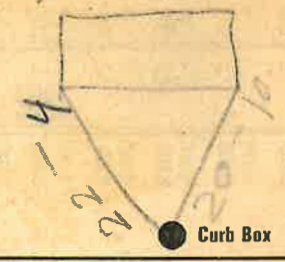

Main Elev of Main at tap *5 1/2*

Gate at ● ● Gate at

● Curb Box

new Tap

TAX ID # 302.20-24-19