

LABOR AND MATERIALS


1	Copper Lead	Connection	1 1/2"	\$	
1	Curb	Clock Valve T. S. & V.	1 1/2 in.	\$	
	Service box Old returned	Short 3 1/2 X 4 1/2 Long 4 1/2 X 5 1/2 Buff or Rdway	Some	\$	
10	Ft. 1 1/2 in.	Copper Galv. Iron Cast Iron	Pipe at	\$	
	Nipples		in. at	\$	
	Bushings		to in. at	\$	
	Red'g Inc'g	Couplings	to in. at	\$	
	Union		in. at	\$	
	Meter		in. at	\$	
	Lead Joints at			\$	
	Compound Joints at			\$	
8	Hrs. Foreman at			\$	
1	Hrs. Chauffeur at	8 1/2 hr		\$ 6.60	
1	Hrs. Tapper at			\$ 83.00	
36	Hrs. Labor at	7 1/2 hr		\$ 25.74	
	Hrs. Labor at			\$	
	Hrs. Compressor at			\$	
	Compensation Ins.			\$ 91	
	Trucking			\$ 1-	
	Builders Use of Water			\$	
	Tap by Warsinski			\$	
				\$	
				\$	
				\$	
				\$	

177

St. Maple
 Ave. No. 190

Name of Owner
Scates

Labor and Mat'l. Report Dec 5 19 46

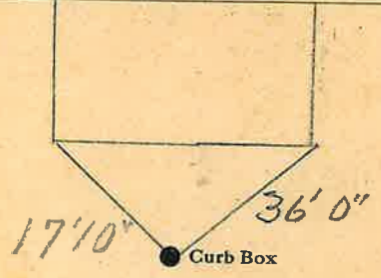

6 Gal Main
 Elev. of Main at tap 6
 Gate at ● Gate at ●

● Curb Box
 TAX ID # 303.17-13-18

LSM-5C-6-1-45 To be paid for. ✓