

Labor and Materials

Copper } Connection.....	?	\$ 1.25
Lead }	?
Curb } Cock Valve }	in	\$ 1.70
} T.S.&V. }
Service Box } Short 3 1/2 x 1 1/2 }		\$ 1.45
Old returned } Long 4 1/2 x 5 1/2 }
} Ruff or Rower }
10 Ft. ^{3/4} in. } Copper } Pipe at 13 1/2 cts. }		\$ 1.25
} Galv. Iron }
} Cast Iron }
Nipples in. at		\$
Bushings to in. at		\$
Red'g } Couplings..... to in. at		\$
Inc'g }
Union..... in. at		\$
Meter..... in. at		\$
Lbs. Br. Stone at		\$
Lbs. Sand at		\$
Bags Cement at		\$
Paving Brick } Mack } at		\$
} Red }
} Asphalt }
Lead Joints at		\$
Leadite Joints at		\$
3 Hrs. Foreman at 6 1/2 hrs. }		\$ 1.88
4 Hrs. Common Labor at .50 }		\$ 2.00
11 Hrs. Common Labor at .45 }		\$ 4.95
Hrs. Mason at		\$
Hrs. Masons Helper at		\$
3 Hrs. Compressor at 1.50 }		\$ 4.50
Compensation Ins }		\$ 3.33
Trucking }		\$ 1.00
Builders Use of Water Patch..... }		\$ 9.00
Total \$ 29.41		


1935-14

Labor and Material Report

Cipi 18

1935

194 Maple St

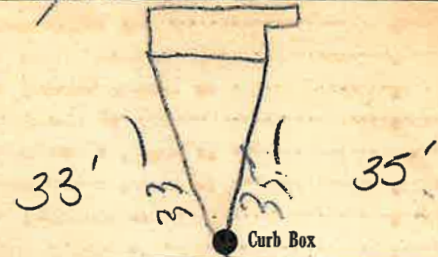

6 Main

Elev. of Main at tap 5

Gate at 10' to main

Gate at

● Curb Box

old shut off at main

TAX ID # 303.17-13-19