

**Labor and Materials**

Copper } Connection.....	3	\$ 2.70
Lead }.....		
Curb } Cock Valve }..... in.....	3/4	\$ 2.39
} T. S. & V. }.....	1/4	
Service Box } Short 3/4x4 1/2 }.....		\$ 1.55
Old returned } Long 4 1/2x5 1/2 }.....		
} Buff. or Redway }.....		
10) Ft..... in. } Copper } Pipe at.....	3/4	\$ 2.70
} Galv. Iron }.....		
} Cast Iron }.....		
Nipples..... in. at.....		\$
Bushings..... to..... in. at.....		\$
Red'g } Couplings..... to..... in. at.....		\$
Inc'g }.....		
Union..... in. at.....		\$
Meter..... in. at.....		\$
Lbs. Br. Stone at.....		\$
Lbs. Sand at.....		\$
Bags Cement at.....		\$
Paving Brick } Mack } at.....		\$
} Red }.....		
} Asphalt }.....		
Lead Joints at.....		\$
Leadite Joints at.....		\$
4) Hrs. Foreman at.....		\$ 2.50
18) Hrs. Common Labor at.....		\$ 8.10
Hrs. Common Labor at.....		\$
Hrs. Mason at.....		\$
Hrs. Mason's Helper at.....		\$
2) Hrs. Compressor at.....		\$ 3.-
Compensation Ins.....		\$ .33
Trucking.....		\$ 1.-
Builders' Use of Water Patch.....		\$ .25-
Total \$		49.27

30-123

**Labor and Material Report**

*July 31 1920*

24 *Simple Street*



#24 - #26 TAX ID # 302.20-24-20

6 Main


Elev of Main at tap


Gate at ●

● Gate at

● Curb Box

*old tap disconnected*

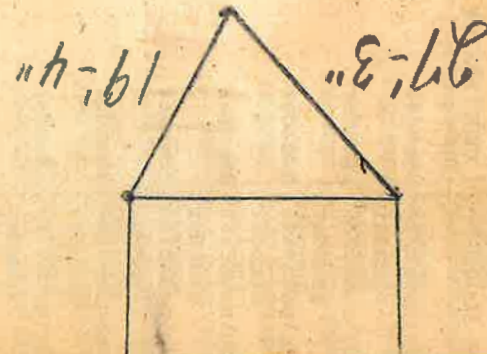

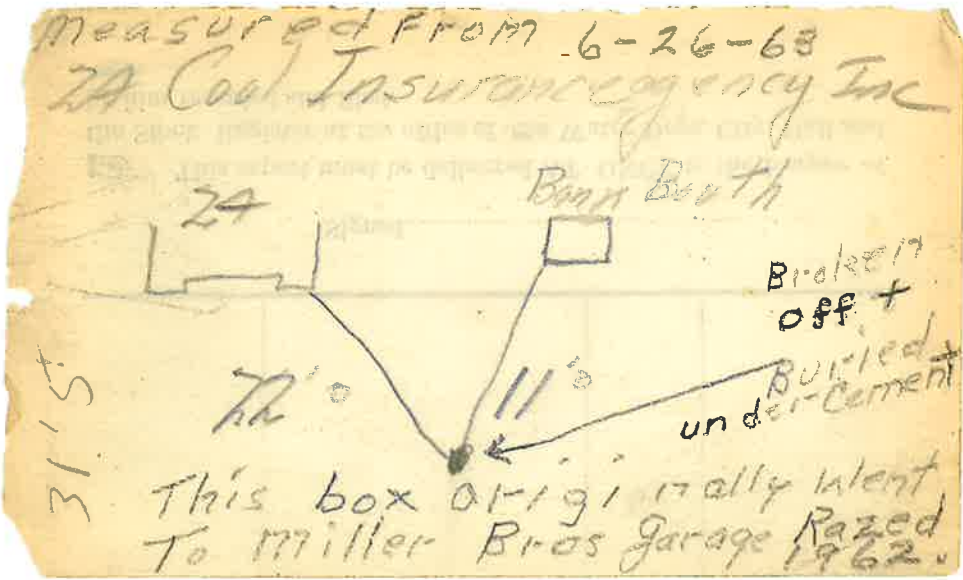

This box originally went  
 To Miller Bros Garage Razed  
 1962.

