


LABOR AND MATERIALS

1 Copper } Connection 1" \$
 Lead }
 1 Curb } Cock } 1 in. - or seal -
 Valve }
 T.S. & W. }
 1 Service box { Short 3 1/2 x 4 1/2 }
 Old returned { Long 4 1/2 x 6 1/2 }
 { Diff. or Redway } \$
 31 Ft. 1 in. { Copper } Pipe at \$
 { Gal. }
 Nipples in. at \$
 Bushings to in. at \$
 Red'g }
 Inc'g } Coupl'gs to in. at \$
 Union in. at \$
 Meter in. at \$
 Lead Joints at \$
 Compound Joints at \$
 Maintenance Foreman \$
 Hrs. Water Maint. Man-1 at \$
 Hrs. Water Maint. Man-2 at \$
 Hrs. Garage Foreman at \$
 Hrs. Labor- at \$
 Hrs. Compressor at \$
 Compensation Ins. at \$ per C \$
 Trucking \$
 Pav't Patch \$
 Tap By Beecher to \$
 O'head MAY-9-1974 \$
 \$
 \$

Maple St. ^{PF} No. 207
 Ave. No.

Name of Owner
 Donohues Market

Labor and Mat'l. Report MAY 9 1974

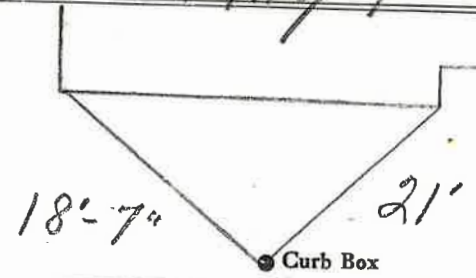

6" Main Elev. of Main at tap 6'
 Gate at ● Gate at ●

● Curb Box

TAX ID # 303.17-22-2

