


LABOR AND MATERIALS

|   |                            |  |           |    |       |
|---|----------------------------|--|-----------|----|-------|
| 1 | Copper Lead                | Connection   | 3/4"      | \$ | _____ |
| 1 | Curb                       | Cock Valve   | 3/4 in.   | \$ | _____ |
|   |                            | T.S. & V.  |           |    |       |
| 1 | Service box                | } Short 3 1/2 x 4 1/2<br>Long 4 1/2 x 5 1/2<br>Buff or Rdway |           | \$ | _____ |
|   | Old returned               |  |           |    |       |
|   |                            |  |           |    |       |
| 9 | Ft.                        | Copper   | } Pipe at | \$ | _____ |
|   | 3/4 in.                    | G.I.   |           |    |       |
|   |                            | G.I.   |           |    |       |
|   | Nipples                    | in. at   |           | \$ | _____ |
|   | Bushings                   | to in. at  |           | \$ | _____ |
|   | Red'g                      | } Coupl'gs   | to in. at | \$ | _____ |
|   | Inc'g                      |  |           |    |       |
|   | Union                      | in. at   |           | \$ | _____ |
|   | Meter                      | in. at   |           | \$ | _____ |
|   | Lead Joints at             |  |           | \$ | _____ |
|   | Compound Joints at         |  |           | \$ | _____ |
|   | Maintenance Foreman        |  |           | \$ | _____ |
|   | Hrs. Water Maint. Man-1 at |  |           | \$ | _____ |
|   | Hrs. Water Maint. Man-2 at |  |           | \$ | _____ |
|   | Hrs. Garage Foreman at     |  |           | \$ | _____ |
|   | Hrs. Labor at              |  |           | \$ | _____ |
|   | Hrs. Compressor at         |  |           | \$ | _____ |
|   | Compensation Ins. at \$    | per C  |           | \$ | _____ |
|   | Trucking                   |  |           | \$ | _____ |
|   | Pay't Patch                |  |           | \$ | _____ |
|   | Tap by Wadleigh &          |  |           | \$ | _____ |
|   | Lab-reau 7-22-57           |  |           | \$ | _____ |
|   | O'head                     |  |           | \$ | _____ |

St. Maple  
 Pt. Maple  
 Ave. No. 208

Name of Owner Edward F. O'Connell

Labor and Mat'l. Report July 22 1957

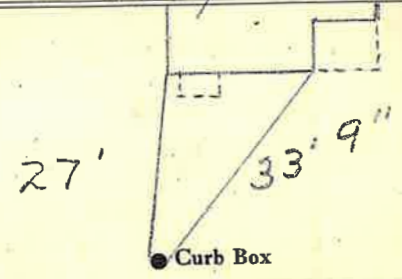

6" Main Elev. of Main at tap 6'  
 Gate at • Gate at

• Curb Box

tax id # 303.17-14-17