

LABOR AND MATERIALS

1 Copper } Connection 3/4" \$  
~~Lead~~  
 1 Curb } Cock } 3/4 in. original \$  
 } Valve }  
 } ~~To Sub V.~~ }  
 1 Service box { Short ~~3 1/2 x 4 1/2~~ }  
 Old returned { Long 4 1/2 x 5 1/2 } \$  
 { ~~But on R/Way~~ }  
 10 Ft. 3/4 in. { Copper } Pipe at \$  
 { ~~Lead~~ }  
 Nipples \_\_\_\_\_ in. at \$  
 Bushings \_\_\_\_\_ to \_\_\_\_\_ in. at \$  
 Red'g }  
 Inc'g } Coupl'gs \_\_\_\_\_ to \_\_\_\_\_ in. at \$  
 Union \_\_\_\_\_ in. at \$  
 Meter \_\_\_\_\_ in. at \$  
 Lead Joints at \$  
 Compound Joints at \$  
 Maintenance Foreman \$  
 Hrs. Water Maint. Man-1 at \$  
 Hrs. Water Maint. Man-2 at \$  
 Hrs. Garage Foreman \_\_\_\_\_ at \$  
 Hrs. Labor \_\_\_\_\_ at \$  
 Hrs. Compressor at \$  
 Compensation Ins. at \$ \_\_\_\_\_ per C \$  
 Trucking \$  
 Pav't Patch \$  
TAP MADE BY GIFFORD & CO \$  
MAY 21-1975 \$  
 O'head \_\_\_\_\_ \$  
 \_\_\_\_\_ \$

Maple


St. 214  
 Ave. No.

Name of Owner

Gerald Sullivan

Labor and Mat'l. Report

MAY 21 1975

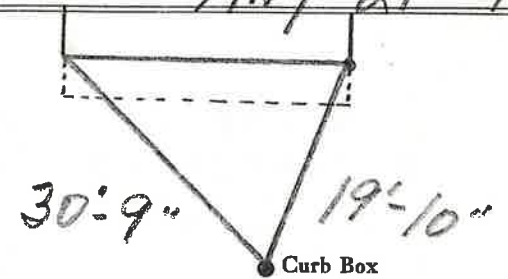

6" Main

Elev. of Main at tap 6"

Gate at ●

● Gate at

● Curb Box

