

### LABOR AND MATERIALS

1	Copper Lead	Connection 1/4"	\$ 7.81
1	Curb	Cock Valve T-S. & V. } 2" in.	\$ 18.35
1	Service box	Short 3/4 X 4 1/2	\$ 15.00
	Old returned	Long 4 1/2 X 5 1/2 Buff or Rdway	
24	Ft.	2" in. Copper	95 19.95
4	Ft.	1/4" in. C.I. } Pipe at	49 1.96
1	Nipples	1/4" in. at Gal. apter	\$ 1.88
	Bushings	to in. at	\$
	Red'g		\$
1	Inc'g	Coupl'gs 1/4" to 2" in. at	\$ 3.19
1	Union	2" in. at	\$ 4.70
	Meter	in. at	\$
	Lead Joints	at	\$
	Compound Joints	at	\$
	Hrs. Water Maint. Man-1	at	\$
16	Hrs. Water Maint. Man-2	at 1.02	\$ 16.32
10	Hrs. Labor-	at 91	\$ 9.10
	Hrs. Labor-	at	\$
4	Hrs. Compressor	at 1.20	\$ 4.80
	Compensation Ins.	at \$ 2.18 per C	\$ .55
	Trucking		\$ 2.00
	Pav't Patch		\$ 14.85
	Top by McGowan		\$
	O'head		\$
			\$ 120.46


7

St.  
Pl.  
Ave. No. 219

Maple

Name of Owner  
Clark Motor Sales

Labor and Mat'l. Report Dec 15 1946

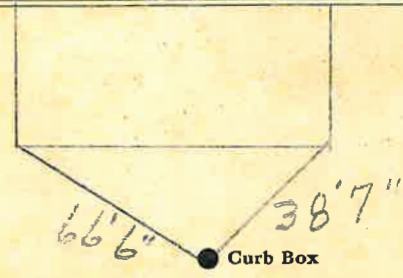

6 Main Elev. of Main at tap 7

Gate at ● ● Gate at

● Curb Box

TAX ID # 303.17-23-2