


LABOR AND MATERIALS

|                       |  |             |    |
|-----------------------|--|-------------|----|
| 1 Copper Lead         | { Connection                             | 3/4 gate    | \$ |
| 1 Curb                | { Gook Valve T. S. & V.                  | 1 in. Valve | \$ |
| 1 Service Box         | { Short 3 1/2 x 4 1/2 Long 4 1/2 x 5 1/2 | }           | \$ |
| Old returned          |  |             |    |
| 19 Ft. 1 in.          | { Copper Galv Iron Cast Iron             | Pipe at     | \$ |
| Nipples               | in. at                                   |             | \$ |
| Bushings              | to in. at                                |             | \$ |
| Red'g Inc'g           | { Couplings                              | to in. at   | \$ |
| Union                 | in. at                                   |             | \$ |
| Meter                 | in. at                                   |             | \$ |
| Lead Joints           | at                                       |             | \$ |
| Leadite Joints        | at                                       |             | \$ |
| Hrs. Foreman          | at                                       |             | \$ |
| Hrs. Chauffeur        | at                                       |             | \$ |
| Hrs. Tapper           | at                                       |             | \$ |
| Hrs. Labor            | at                                       |             | \$ |
| Hrs. Labor            | at                                       |             | \$ |
| Hrs. Compressor       | at                                       |             | \$ |
| Compensation Ins.     |  |             | \$ |
| Trucking              |  |             | \$ |
| Builders Use of Water |  |             | \$ |
|                       |  |             | \$ |
|                       |  |             | \$ |
|                       |  |             | \$ |
|                       |  |             | \$ |

St. Maple  
 Pl. Maple  
 Ave. No. 28

Name of Owner First Nat. Bank  
Miller Bros. Drive-in

Labor and Mat'l. Report April 20 1918

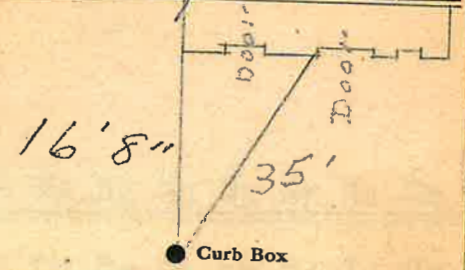

6" Main Elev. of Main at tap

Gate at ● Gate at ●

#28 - #32 TAX ID # 302.20-24-21

● Curb Box  
 This Place  
 razed  
 1962  
 shot off at curb