

LABOR AND MATERIALS


Copper	} Connection		\$		
Lead					
Curb	{ Clock Valve	} in.	\$		
	{ T. S. & V.				
Service box	} Short 3 1/4 X 4 1/4		\$		
Old returned					Long 4 1/4 X 5 1/4
					Buff or Rdway
Ft.	} Copper	} Pipe at	\$		
					Galv. Iron
					Cast Iron
Nipples	in. at		\$		
Bushings	to	in. at	\$		
Red'g	} Couplings	to	\$		
Inc'g					in. at
Union	in. at		\$		
Meter	in. at		\$		
Lead Joints	at		\$		
Compound Joints	at		\$		
Hrs. Foreman	at		\$		
Hrs. Chauffeur	at		\$		
Hrs. Tapper	at		\$		
Hrs. Labor	at		\$		
Hrs. Labor	at		\$		
Hrs. Compressor	at		\$		
Compensation Ins.			\$		
Trucking			\$		
Builders Use of Water			\$		
Measured by <i>Walski</i>				\$	
<i>Geo</i>				\$	
				\$	
				\$	
				\$	
				\$	

St.
 Pl.
 Ave. No. 227

Maple St

Name of Owner _____

Labor and Mat'l. Report *June* 1945

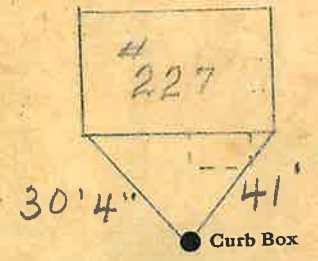

Elev. of
Main at tap.....

..... Main

Gate at ● ● Gate at

~~#~~ 2" ● Curb Box

Wheel Valve
at Curb.

Labor and Materials

..... Lead Connection	\$
1. Curb Box 6" Gate	\$
1. Service Box (Short 3" x 4" Galv Old returned Long 4" x 5" Box Buffalo Box)	\$
30. Ft. 6" in. Galv Pipe at C.L. Pipe	\$
..... Nipples in. at	\$
..... Bushings in. at	\$
..... Red'g Coup... to... in. at	\$
..... Inc'g Coup... to... in. at	\$
1. Union in. at 6" Pipe	\$ 1
1. Meter in. at 6" Sleeve	\$
..... Cu. Yds. Br. Stone at	\$
..... Cu. Yds. Sand at	\$
..... Bags Cement at	\$
..... Pav. Brick { Mack Red Asphalt } at	\$
1.2 Hrs. Foreman at	\$
1.00 Hrs. Com. Labor at	\$
..... Hrs. Mason at	\$
..... Hrs. at	\$
..... Hrs. at	\$
9.0 Builders' Use of Water	\$
..... at	\$
Truck 1.50	\$
7- funds	\$
..... at	\$
Total \$ 119.82	

Labor and Material Report ^{Oct} 10 to 13 1924

6" Tap to 141 Maple St
Fowler Curtis Co.

● Curb Box

6" Main Elev. of Main at tap 6'
● Gate at ● Gate at

● Curb Box