

LABOR AND MATERIALS

1	Copper Lead	} Connection	3/4 in.	\$
1	Curb			
		} Cock Valve T.S. & V.	3/4 in.	\$
1	Service box Old returned			
		} Short 3 1/2 x 4 1/2 Long 4 1/2 x 5 1/2 Buff or Rdway		\$
23	Ft. 10 in.			
		} Copper G.I. G.I.	Pipe at 3/4"	\$
	Nipples			
	Bushings	to in. at	\$	
	Red'g Inc'g	} Coupl'gs	to in. at	\$
	Union			
	Meter	in. at	\$	
	Lead Joints	at	\$	
	Compound Joints	at	\$	
	Maintenance Foreman		\$	
	Hrs. Water Maint. Man-1	at	\$	
	Hrs. Water Maint. Man-2	at	\$	
	Hrs. Garage Foreman	at	\$	
	Hrs. Labor	at	\$	
	Hrs. Compressor	at	\$	
	Compensation Ins.	at \$ per C	\$	
	Trucking		\$	
	Pav't Patch		\$	
	Tap by Trececot		\$	
		09-14-78	\$	
	O'head		\$	
			\$	


Maple

St. Pl. Ave. No 229

Name of Owner

Leonard DuFour

Labor and Mat'l. Report Sept 14, 1978

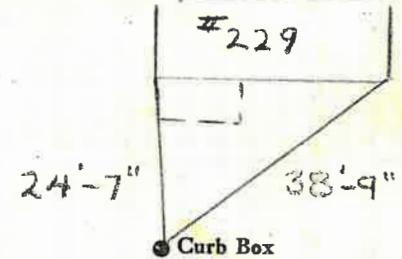

6" Main

Elev. of Main at tap 5'

Gate at ●

● Gate at

TAX ID # 303.18-11-7

● Curb Box

Volc