

LABOR AND MATERIALS

Copper Lead	Connection	3/4		\$ 1.35
1 Curb	Cock Valve T. S. & V.	3/4	in.	\$ 1.88
1 Service Box Old returned	Short 3 1/2 x 4 1/2 Long 4 1/2 x 5 1/2 Buff. or Rdway			\$ 1.82
22 Ft. 3/4 in.	Copper Galv. Iron Cast-Iron	Pipe at 20		\$ 4.40
Nipples	in. at			\$
Bushings	to in. at			\$
Red'g Inc'g	Couplings to in. at			\$
Union	in. at			\$
Meter	in. at			\$
Lead Joints	at			\$
Leadite Joints	at			\$
Hrs. Foreman	at			\$
Hrs. Chauffeur	at			\$
8 Hrs. Tapper	at	.683/4		\$ 5.50
Hrs. Labor	at			\$
Hrs. Labor	at			\$
2 Hrs. Compressor	at	92		\$ 1.84
Compensation Ins.				\$.17
Trucking				\$ 1.00
Builders Use of Water	1/2 Patch (Quinn)			\$ 9.00
Tools/Hassel				\$
2 bills impassant depth				\$
pay for				\$
				\$ 26.96

H.

10 1942

St.

~~Pl~~

Maple

Ave. No.

231


Name of Owner

O'Connor

Labor and Mat'l. Report

Apr 16

1912

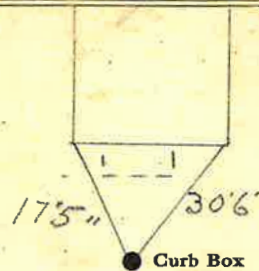

● Curb Box

6 Main

Elev. of

Main at tap

5

Gate at ●

● Gate at

TAX ID # 303.18-11-6

● Curb Box