


LABOR AND MATERIALS

|    |                            |  |                 |    |
|----|----------------------------|--|-----------------|----|
| 1  | Copper Lead                | Connection   | 3/4"            | \$ |
| 1  | Curb                       | Cock Valve T.S. & V.                                       | 3/4 in. oriseal | \$ |
| 1  | Service box Old returned   | Short 3 1/2 x 4 1/2<br>Long 4 1/2 x 5 1/2<br>Buff or Rdway |                 | \$ |
| 11 | Ft.                        | 3/4 in. Copper G.I. C.I.                                   | Pipe at         | \$ |
|    | Nipples                    | in. at   |                 | \$ |
|    | Bushings                   | to in. at  |                 | \$ |
|    | Red'g Inc'g                | Coupl'gs. to in. at  |                 | \$ |
|    | Union                      | in. at   |                 | \$ |
|    | Meter                      | in. at   |                 | \$ |
|    | Lead Joints at             |  |                 | \$ |
|    | Compound Joints at         |  |                 | \$ |
|    | Maintenance Foreman        |  |                 | \$ |
|    | Hrs. Water Maint. Man-1 at |  |                 | \$ |
|    | Hrs. Water Maint. Man-2 at |  |                 | \$ |
|    | Hrs. Garage Foreman at     |  |                 | \$ |
|    | Hrs. Labor at              |  |                 | \$ |
|    | Hrs. Compressor at         |  |                 | \$ |
|    | Compensation Ins. at \$    | per C  |                 | \$ |
|    | Trucking                   |  |                 | \$ |
|    | Pav't Patch                |  |                 | \$ |
|    | Tap by Hareau & Co.        |  |                 | \$ |
|    | 1-27-71.                   |  |                 | \$ |
|    | O'head                     |  |                 | \$ |

St. Maple  
 Pl. 234  
 Ave. No. 234

Name of Owner Francis O'Conner

Labor and Mat'l. Report Jan 27 19 71

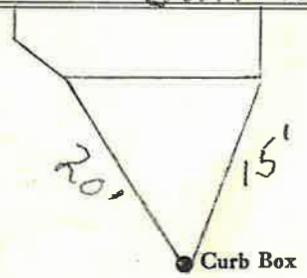

6" Main      Elev. of Main at tap 4'  
 Gate at •      • Gate at

TAX ID # 303.18-11-14.1

• Curb Box